

LIBER

2 PAGE 396

LAND CORNER RECORDATION CERTIFICATE
Filing Requirement of Act 74, Mich. P.A. 1970

STATE OF MICHIGAN
COUNTY OF CRAWFORD

FILED FOR RECORD THIS
6th DAY OF June 1990
9:30 am, IN LIBER 2
PAGE 396.

Elizabeth Widland
Register of Deeds

Register of Deeds Stamp & File Number

| | | | |
|-----------------------------|-------------------|----------------|--|
| or corners in | | | |
| <u>Crawford</u> (County) | Located In: | Corner Code: # | |
| Public Land Survey | T <u>26NR 1W</u> | <u>I-3</u> | |
| | T ___ R ___ | _____ | |
| | T ___ R ___ | _____ | |
| | T ___ R ___ | _____ | |
| Property Controlling | S ___ T ___ R ___ | _____ | |
| In Section | S ___ T ___ R ___ | _____ | |
| Miscellaneous | S ___ T ___ R ___ | _____ | |
| Property in Sec. | S ___ T ___ R ___ | _____ | |

Lot No. _____, Recorded Plat _____
Private Claims _____


Norman C. Caldwell in a field survey on March, 1990
I hereby certify that under requirements of P.A. 74, Michigan P.A. of 1970, the corner points mentioned in lines 1 and 2 above were in conformance with regulations and rules therefore as required in the current manual of survey instructions of the United States Department of the Interior, Bureau of Land Management or by a decree of a Court of Law and/or that the corner points mentioned in lines 3, 4 and 5 above were in conformance with the rules of the Michigan Board of Land Surveyors or by a Decree of a Court of Law; established, re-established, monumented, re-monumented, recovered, found as pressed below:

NOTE: Not more than 4 corners, all in the same town and range, may be recorded on this certificate.

Description of original monument and accessories and/or subsequent restoration:

(I-3) Bank of Au Sable River, set meander post, both East and South.

| | A | B | C | D | E | F | G | H | I | J | K | L | M |
|----|----|----|----|----|----|----|---|---|---|---|---|---|---|
| 2 | 6 | 5 | 4 | 3 | 2 | 1 | | | | | | | |
| 3 | | | | | | | | | | | | | |
| 4 | 7 | 8 | 9 | 10 | 11 | 12 | | | | | | | |
| 5 | | | | | | | | | | | | | |
| 6 | 13 | 14 | 15 | 16 | 17 | 18 | | | | | | | |
| 7 | | | | | | | | | | | | | |
| 8 | 19 | 20 | 21 | 22 | 23 | 24 | | | | | | | |
| 9 | | | | | | | | | | | | | |
| 10 | 25 | 26 | 27 | 28 | 29 | 30 | | | | | | | |
| 11 | | | | | | | | | | | | | |
| 12 | 31 | 32 | 33 | 34 | 35 | 36 | | | | | | | |
| 13 | | | | | | | | | | | | | |

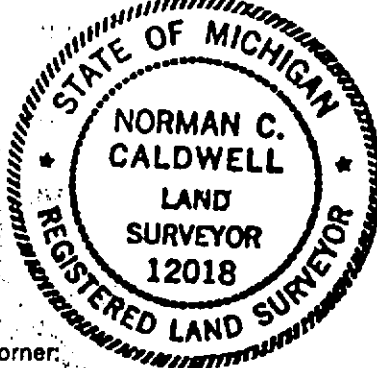

Description of corner evidence found and/or method applied in restoring or reestablishing corner:

(I-3) 6" x 5' conc. mons. placed by Griffin, LS 13584, E&S of Sec. corner position at identified US meander corners.
XX

(I-3) Sec. cor. 2,3,10&11, T26N-R1W

Fnd. 6" conc. mon. w/3" brass cap S of River "RLS 13584".
And is accepted as a careful & faithful perpetuation of the position of the original corner.
East 0.5' Carsonite Witness Post
West 41.9' 36" R. Pine
S08°W 51.7' 12" Maple
N80°W 27.4' 12" Maple
S28°E 117.5' P. Pole

Description of monument for corner and accessories established to perpetuate locating the position of the corner:

(I-3) Sec. cor. 2,3,10&11, T26N-R1W

Fnd 6" conc. mon. w/3" brass cap E of River "RLS 13584". And is accepted as a careful & faithful perpetuation of the position of the original corner.
North 1' Carsonite Witness Post
N30°E 19.7' 6" W. Pine
N78°E 14.0' 12" Oak
S14°E 9.7' 5" W. Pine
N40°W 31.0' 10" R. Pine

signed by Norman C. Caldwell

Date April 26, 1990

Surveyor's Michigan License No. 12018