

LAND CORNER RECORDATION CERTIFICATE
Filing Requirement of Act 74, Mich. P.A. 1970

STATE OF MICHIGAN
COUNTY OF CRAWFORD

FILED FOR RECORD THIS
6th DAY OF June 1990
9:30 pm, IN LIBER 2
PAGE 397.
Edgith D. Wieland
Register of Deeds

or corners in
Crawford
(County)

Located In: Corner Code: K-2

Public Land Survey	T 26N R 1W	K-2
	T R	
	T R	
	T R	
Property Controlling In Section	S T R	
Miscellaneous	S T R	
Property In Sec.	S T R	

Register of Deeds Stamp & File Number

Lot No. _____, Recorded Plat _____
Private Claims _____

Norman C. Caldwell field survey on March, 1990
hereby certify that under requirements of P.A. 74, Michigan P.A. of 1970, the corner points mentioned in lines 1 and 2 above were in conformance with regulations and rules therefore as required in the present manual of survey instructions of the United States Department of the Interior, Bureau of Land Management or by a decree of a Court of Law and/or that the corner points mentioned in lines 3, 4 and 5 above were in conformance with the rules of the Michigan Board of Land Surveyors or by a Decree of a Court of Law; established, re-established, monumented, re-monumented, recovered, found as expressed below:

NOTE: Not more than 4 corners, all in the same town and range, may be recorded on this certificate.

Description of original monument and accessories and/or subsequent restoration:

- (K-2) Post set by Pettibone, May 28; 1852.
Pine 12" N52°W .13 (8.58')
- Birch 12" S60°E .16 (10.56')


Description of corner evidence found and/or method applied in restoring or reestablishing corner:

- (K-2) E. Houghton placed clay tile mon. from both orig. BTs.
Mon. fnd. & utilized by Henning, LS 2240, (1951)
N. Parker, LS 16939, used mon. & rec. in L 1, pg 213 & L 1, pg 214

Description of monument for corner and accessories established to perpetuate locating the position:

- (K-2) 1/4 cor. 1&2, T26N-R1W
Fnd. clay tile filled w/conc. 4" in dia. w/3/4" iron bar, metal fence post along side. And is accepted as a careful & faithful perpetuation of the position of the original corner.
North 0.5' Carsonite Witness Post S48°W 43.8' 4" W. Pine
N40°W 30.3' old Pine stump N68°E 9.2' 4" Birch
N20°W 86.5' 7" W. Pine
N86°W 44.5' 5" W. Pine

	A	B	C	D	E	F	G	H	I	J	K	L	M
2	6	5	4	3	2								
3													
4	7	8	9	10	11	12							
5													
7													
8	19	20	21	22	23	24							
9													
10	30	29	28	27	26	25							
11													
12	31	32	33	34	35	36							
13													

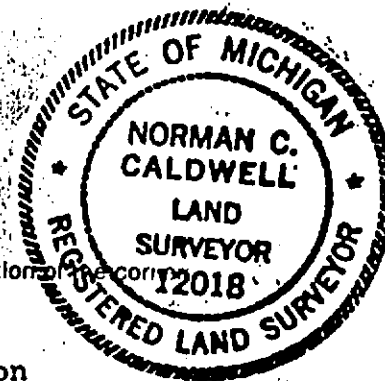

signed by Norman C. Caldwell Date April 26, 1990
Surveyor's Michigan License No. 12018