

LIBER

2 PAGE 398

LAND CORNER RECORDATION CERTIFICATE  
Filing Requirement of Act 74, Mich. P.A. 1970

STATE OF MICHIGAN  
COUNTY OF CRAWFORD

corners in

Crawford  
(County)

Located In:

Corner Code #

Public Land Survey

T 26N R 1W

K-3

Property Controlling  
In Section

S T R

Miscellaneous

S T R

Property In Sec.

S T R

FILED FOR RECORD THIS  
DAY OF June, 1990 AT  
9:30 am, IN LIBER 2  
PAGE 398

*Elizabeth M. Wieland*  
Register of Deeds

Register of Deeds Stamp & File Number

Lot No. \_\_\_\_\_, Recorded Plat \_\_\_\_\_

Private Claims \_\_\_\_\_

Norman C. Caldwell

in a field survey on \_\_\_\_\_, 19 \_\_\_\_\_

I hereby certify that under requirements of P.A. 74, Michigan P.A. of 1970, the corner points mentioned in lines 1 and 2 above were in conformance with regulations and rules therefore as required in the current manual of survey instructions of the United States Department of the Interior, Bureau of Land Management or by a decree of a Court of Law and/or that the corner points mentioned in lines 3, 4 and 5 above were in conformance with the rules of the Michigan Board of Land Surveyors or by a Decree of a Court of Law, established, re-established, monumented, re-monumented, recovered, found as pressed below:

NOTE: Not more than 4 corners, all in the same town and range, may be recorded on this certificate.

Description of original monument and accessories and/or subsequent restoration:

- (K-3) Post set by Pettibone, May 28, 1852.  
Pine 15" N54°W .13 (8.58')
- Pine 17" S79°E .25 (16.50')


Description of corner evidence found and/or method applied in restoring or reestablishing corner:

- (K-3) C.E. Ostling, LS 12026, fnd. 1/2" bar of unknown origin.  
S23°W 79.2' 12" Oak  
N58°W 94.4' 14" Oak  
rec. in L 1, pg 238  
(4"x36" conc. mon. placed for recorded plat of "RED DOG")

Description of monument for corner and accessories established to perpetuate locating the position of the corner:

- (K-3) Sec. cor 1,2,11&12, T26N-R1W  
Fnd 4" conc. mon. w/1/2" rerod @ Westerly edge of Rd.  
as replacement of C.E. Ostling 1/2" bar. Accepted as a careful & faithful reestablishment of the position of the original corner.  
North 0.5' Carsonite Witness Post N42°E 50.6' 12" Oak  
North 44.7' 9" Oak  
N52°W 25.0' 15" Oak  
S16°E 23.3' 9" Oak

	A	B	C	D	E	F	G	H	I	J	K	L	M
2													
3													
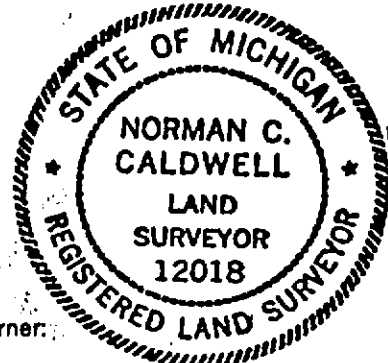

Signed by *Norman C. Caldwell*

Date April 26, 1990

Surveyor's Michigan License No. 12018