

APR 27 1995

COMMISSION

CRAWFORD COUNTY
PEER GROUP APPROVAL
DATE Dec 22, 1994

LIBER 3 PAGE 153

LAND CORNER RECORDATION CERTIFICATE
Filing Requirement of Act 74, Mich. P.A. 1970

For corners in

Crawford (County)	Located In:	Corner Code #
1. Public Land Survey	T 26N R 3W	C - 3
	T R	
	T R	
	T R	
2. Property Controlling in Section	S T R	
	S T R	
3. Miscellaneous Property in Sec.	S T R	
	S T R	
4. Lot No. _____, Recorded Plat _____		
5. Private Claims _____		

STATE OF MICHIGAN

COUNTY OF CRAWFORD

FILED FOR RECORD THIS
30th DAY OF Dec, 1994 AT
4:20 am (pm) IN LIBER 3
PAGE 153.

Edith H. Wiland
Register of Deeds Stamp & File Number
Register of Deeds

I, Marvin E. Myers, in a field survey on December 16, 1994

do hereby certify that under requirements of P.A. 74, Michigan P.A. of 1970, the corner points mentioned in lines 1 and 2 above were in conformance with regulations and rules therefore as required in the current manual of survey instructions of the United States Department of the Interior, Bureau of Land Management or by a decree of a Court of Law and/or that the corner points mentioned in lines 3, 4 and 5 above were in conformance with the rules of the Michigan Board of Land Surveyors or by a Decree of a Court of Law; established, re-established, monumented, re-monumented, recovered, found as expressed below:

NOTE: Not more than 4 corners, all in the same town and range, may be recorded on this certificate.

A. Description of original monument and accessories and/or subsequent restoration:


GLO-A.P. Brewer 1852 Mon-Set Post WIT: 10" S.Pine N86°E 35 lks. 10" S.Pine S08½°W 8 lks.	Surveyor & Date unknown Mon-½" bar WIT: None	N. Parker Oct. 27, 1976 L.2, pg.93 LCRC Mon-1" Pipe in C Rd. intersection WIT: Face of guy pole N45°E 49.7' Spike in NE side P.Pole N45°W 42.6'
R. Ostling May 1946 Mon-Fd. ½" bar WIT: N.B.T. 10" S.Pine S60½°E 71.9' N.B.T. 8" B.Oak S24°E 80.7' N.B.T. 7" S.Pine S56½°W 70.5'	R. Ostling Feb. 1954 Mon-Fd. ½" bar WIT: 10" S.Pine S60½°E 71.9' 8" B.Oak S24°E 80.7' 7" S.Pine S56½°W 70.5'	H. Fluharty Aug. 21, 1985 L.241, pg.638 Mon-Fd. 1" Pipe WIT: P.Pole N67°E 65.60' P.Pole S44°W 51.25' P.Pole N40°W 44.45'

B. Description of corner evidence found and/or method applied in restoring or reestablishing corner:

Monument - Found 1" ID x 17" Iron Pipe with "T" iron over 3/4" ID x 36" Iron Pipe inside Mon. Box in centerline Michigan Ave. and 4' North of centerline North Down River Road
WIT: Fd. nail & tag N. side U.Pole N41°W 44.40'
Fd. tag & nail SE side U.Pole S42°W 51.10'
Accepted as the best available evidence of the position of the original corner.

C. Description of monument for corner and accessories established to perpetuate locating the position of the corner:

Mon-Set Std. Crawford County Mon. stamped "T26N R3W C-3 31600" in Mon. Box in exact location of iron pipe
WIT: Fd. nail & tag N. side U.Pole N41°W 44.40'
Fd. tag & nail SE side U.Pole S42°W 51.10'
Set wit. tag & nail SW side U.Pole N41°W 44.04'
Set wit. tag & nail NE side U.Pole N70°E 68.58'
Set wit. tag 7 nail NE side U.Pole S55°E 76.92'

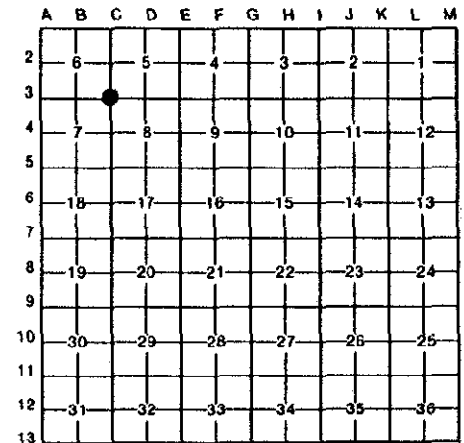

Signed by *Marvin E. Myers*

Date Dec 29, 1994

Surveyor's Michigan License No. 31600

