

CRAWFORD COUNTY REMONUMENTATION  
**LAND CORNER RECORDATION CERTIFICATE**  
 Filing Requirement of Act 74, Mich. P.A. 1970

STATE OF MICHIGAN  
 COUNTY OF CRAWFORD

FILED FOR RECORD THIS  
 5th DAY OF Jan, 1994  
 11:50 am/pm, IN LIBER 3 4c  
 PAGE 129  
 Register of Deeds

For corners in  
 CRAWFORD (County)

Located In: Corner Code #

1. Public Land Survey	T 26N R 3W	E-6
	T _____ R _____	_____
	T _____ R _____	_____
	T _____ R _____	_____
2. Property Controlling in Section	S _____ T _____ R _____	_____
	S _____ T _____ R _____	_____
3. Miscellaneous Property in Sec.	S _____ T _____ R _____	_____
	S _____ T _____ R _____	_____

4. Lot No. \_\_\_\_\_, Recorded Plat \_\_\_\_\_  
 5. Private Claims \_\_\_\_\_

Register of Deeds Stamp & File Number

**LIBER 3 PAGE 129**

I, Marvin E. Myers, in a field survey on Dec, 19 93, do hereby certify that under requirements of P.A. 74, Michigan P.A. of 1970, the corner points mentioned in lines 1 and 2 above were in conformance with regulations and rules therefore as required in the current manual of survey instructions of the United States Department of the Interior, Bureau of Land Management or by a decree of a Court of Law and/or that the corner points mentioned in lines 3, 4 and 5 above were in conformance with the rules of the Michigan Board of Land Surveyors or by a Decree of a Court of Law; established, re-established, monumented, re-monumented, recovered, found as expressed below:


A	B	C	D	E	F	G	H	I	J	K	L	M
2	6	5	4	3	2	1						
3												
4	7	8	9	10	11	12						
5												
6	18	17	16	15	14	13						
7												
8	19	20	21	22	23	24						
9												
10	30	29	28	27	26	25						
11												
12	31	32	33	34	35	36						
13												

**NOTE: Not more than 4 corners, all in the same town and range, may be recorded on this certificate.**

A. Description of original monument and accessories and/or subsequent restoration:  
 GLO 1852 A. Brewer LCRC L.3 P 45 Dec 1991 M.E. Myers  
 Mon- Post Mon- 1/2"x18" bar  
 Wit- 8" Spruce N76°E 19 lks Wit- Nail in SW side 18" TW, Maple N25°W 33.70  
 7" Spruce S40°W 56 lks Nail in W. side 8" Maple S60°E 20.50  
 June 1961 C.E. Ostling Nail in S. side 10" Birch N60°E 31.20  
 Mon- Not given Pk nail in Black Top S28°E 87.73  
 Wit- Not given  
 Position established by  
 Single Proportion Measure

B. Description of corner evidence found and/or method applied in restoring or reestablishing corner:  
 Found 1/2"x18" bar verified position by measurement to accessories of record and accepted as the best available evidence of the Position of the Original Corner.

C. Description of monument for corner and accessories established to perpetuate locating the position of the corner:  
 Mon- Standard 2"x21" Crawford County Monument. NOTE: Corner is located within boundary of Camp AuSable for assistance in location of corner please contact Brenton Bullock, Camp Manager at 517-348-5491  
 Wit- Nail in N Side 10" Maple S40°W 9.58  
 Nail in SW side 18" TW, Maple N25°W 33.70  
 Nail in West side 8" Maple S60°E 20.50  
 Nail in S. side 10" Birch N60°E 31.20  
 Pk nail in Asphalt S28°E 87.73  
 Carsonite post 2.3 South

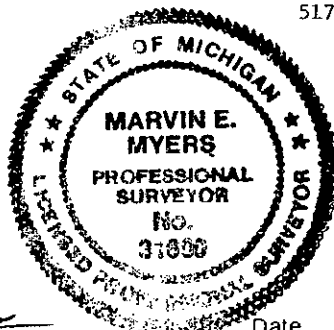

Signed by Marvin E. Myers Date December 29, 1993  
 Surveyor's Michigan License No. 31800