CRAWFORD COUNTY PEER GROUP APPROVAL DATE Dec 22, 1994

LIBER

Τ...

T _

PAGE

APR 27 1995

4:20 am (pm) IN LIBER 3

COMMISSION

LAND CORNER RECORDATION CERTIFICATE Filing Requirement of Act 74, Mich. P.A. 1970

For corners in	· · · · · · · · · · · · · · · · · · ·	and the distance of the trial little to the tr		
Crawford	Located In:	Corner Code ##	STATE OF MICHIGAN	
(County)	Located III.	Conter Code ##	COUNTY OF CRAWFORD	
1. Public Land Survey	T 26N R 3W	E - 7	FILED FOR RECORD THIS	
	1 n		30" DAY OF Dec. 1994 AT	

2. Property Controlling _ T R in Section S _____ T ____ R __ Register of Degds Stamp & File Number Miscellaneous S_ __ R 3. __ T Property in Sec. _ R _ Register of Deeds

___ , Recorded Plat _ 5. Private Claims ___

_ R .


__ R

1. Marvin E. Myers , in a field survey on December 19 do hereby certify that under requirements of P.A. 74, Michigan P.A. of 1970, the corner points mentioned in lines 1 and 2 above were in conformance with regulations and rules therefore as required in the current manual of survey instructions of the United States Department of the Interior, Bureau of Land Management or by a decree of a Court of Law and/or that the corner points mentioned in lines 3, 4 and 5 above were in conformance with the rules of the Michigan Board of Land Surveyors or by a Decree of a Court of Law; established, re-established, monumented, re-monumented, recovered, found as expressed below:

NOTE: Not more than 4 corners, all in the same town and range, may be recorded on this certificate.

A. Description of original monument and accessories and/or subsequent restoration:

GLO-A.P.Brewer 1852 Mon-Set Post
WIT: 10" S.Pine N58°W 35 1ks.
8" S.Pine S47°E 38 1ks. C.E.Ostling June 1961 Mon-Placed 3/4" Pipe WIT: T.Pole N41°W 55.4' 4" B.Oak N86°E 33.2' 12" B.Oak S28°W 105.5' Wit. Cor. 1½" Shaft N68°E 27.6' C MCRR SW'ly 49.8' N.Parker Apr. 8, 1981 L.195, pg.326 Mon-3/4" Pipe of record WIT: 18" W.Oak S30°W 105.3' 18" R.PIne S40°E 115.75'
12" W.Oak N88°E 34.80' 12" W.Oak NO8°W 58.0'

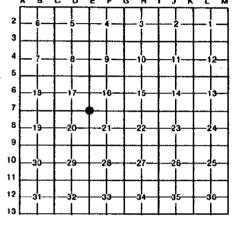

M.E.Myers Aug. 18, 1991 L.3, pg.43 Mon-l" Iron WIT: Nail S. side 18" Pine S70°E 98.15'
Nail N. side 14" Oak S85°E 34.80'
Nail S. side 10" Pine N15°E 53.34'
Nail in rail tie East of East Trail S50°W 45.591

B. Description of corner evidence found and/or method applied in restoring or reestablishing corner:


Monuemnt - Found 3/4" ID x 40" Iron Pipe with flagging laying on its' side in general vicinity WIT: Fd. nail N. side 13" B.Oak S89°E 34.87'
Fd. nail S. side 18" W.Pine S71½°E 98.21'

Fd. nail S. side 18" W.Pine S71½°E 98.21'
Fd. nail in rail tie NE of NE rail S49°W 45.60'
Fd. nail SE side 10" J.Pine N11°E 54.26'
Fd. blaze NW face 18" R.Pine S59°E 115.72'
Fd. 11" Oak stump N07°W 57.94'
Fd. 1½" shaft N72°E 27.40'
Fd. blaze SW face 9" B.Oak N58°E 23.69 (dead)
Fd. blaze NE face 15" B.Oak S31°W 105.47'

Accepted as the best available evidence of the postion of the original corner.

C. Description of monument for corner and accessories established to perpetuate locating the position of the corner:

Surveyor's Michigan License No. _

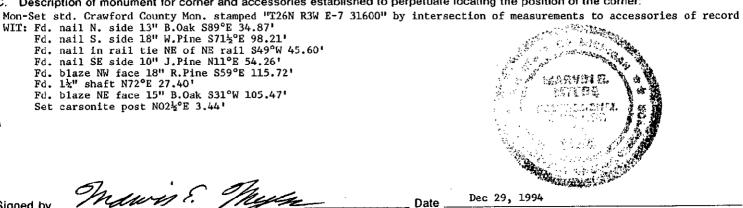

Signed by _	mawis E.	Muse	
J.g.,Ju J, _			

31600

Dec 29, 1994

_ Date