

MAY 05 1997

COMMISSION

LAND CORNER RECORDATION CERTIFICATE


Filing Requirement of Act 74, Mich. P.A. 1970

For corners in Crawford (County)

Located In:

Corner Code #

- 1. Public Land Survey T 26N R 3W F - 5
2. Property Controlling in Section S T R
3. Miscellaneous Property in Section S T R

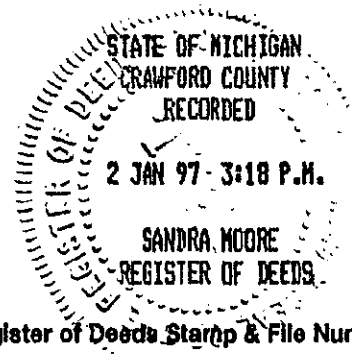

Register of Deeds Stamp & File Number

- 4. Lot No. , Recorded Plat
5. Private Claims

LIBER 3 PAGE 262

I, Marvin E. Myers, in a field survey on December, 19 95, do hereby certify that under requirements of P.A. 74, Michigan P.A. of 1970, the corner points mentioned in lines 1 and 2 above were in conformance with regulations and rules therefore as required in the current manual of survey instructions of the United States Department of the Interior, Bureau of Land Management or by a decree of a Court of Law and/or that the corner points mentioned in lines 3, 4 and 5 above were in conformance with the rules of the Michigan Board of Professional Surveyors or by a Decree of a Court of Law; established, re-established, monumented, re-monumented, recovered, found as expressed below:

Grid table with columns A-L and rows 2-13, containing numbers 1-36.

NOTE: Not more than 4 corners, all in the same town and range, may be recorded on this certificate.

A. Description of original monument and accessories and/or subsequent restoration:

- GLO-James Mullett 1839 Mon.-Set Post WIT: 8" S.Pine N19°E 5 lks. 9" S.Pine S14°E 11 lks.
N. Parker Jan. 1975 L.142, Pg.416 Mon.-1/2" Bar in pav't box WIT: R.R. spike in pav't is 3.2' w'ly of true cor.
G. Boss June 1988 L,280, pg.42 Mon.-R.R. SPIke in Mon. Box WIT: Spike in 9" J.Pine N03°W 55.17' Spike in 9" R.Pine S50°E 52.57' Spike in 16" W.Pine N65°W 100.93' C M-72 South 1.3'
Eugene Ostling Dec. 1971 Mon.-Fd. 1/2" Bar L.1, pg.119 WIT: 18" R.Pine N47°W 121.90' 20" B.Oak South 103.90'
N. Parker Oct. 1984 L.271, pg.567 Mon.-1/2" Iron Bar in pav't WIT: R.R. Spike in Mon. Box is 3.2' W'ly of true cor.
A.E. Newman 1890 Mon.-Set Post WIT: NBT 24" W.Pine N36°E 2.26 chs. O.B.T. Down 8" Spr.Pine S14°E 0.11 chs.

B. Description of corner evidence found and/or method applied in restoring or reestablishing corner:

Found Boat spike 3.2 feet Easterly of a Monument box with RR spike, verified position of Boat spike by measurement to accessories 18" R. Pine N47°W 121.90; 20" B. Oak South 103.90 Accepted Boat spike as the best available evidence of the position of the Original Corner. RR Spike in Mon.Box was not accepted and was not removed.

CRAWFORD COUNTY PEER GROUP APPROVAL DATE Jan 17, 1996

Signature of Marvin E. Myers, P.S., County Surveyor

C. Description of monument for corner and accessories established to perpetuate locating the position of the corner:

- Replaced Boat spike with Standard Crawford County Monument & Monument Box
Wit: Nail & tag in 24" B.Oak S03°W 104.18
Nail & tag in 11" R. Pine S38°E 50.22
Nail & tag in 18" R. Pine N36°W 122.14
Nail & tag in 9" J. Pine N55°E 88.94
RR spike in Monument box Easterly 3.2



Signed by Marvin E. Myers

Date Dec 31, 1996

Surveyor's Michigan License No. 31600