

**SURVEY & REMONUMENTATION**

MAY 05 1997

**LAND CORNER RECORDATION CERTIFICATE**

Filing Requirement of Act 74, Mich. P.A. 1970

**COMMISSION**


For corners in  
Crawford

(County)

Located In:

Corner Code #

- |                                      |   |     |   |    |       |
|--------------------------------------|---|-----|---|----|-------|
| 1. Public Land Survey                | T | 26N | R | 3W | H - 5 |
|                                      | T |     | R |    |       |
|                                      | T |     | R |    |       |
|                                      | T |     | R |    |       |
| 2. Property Controlling in Section   | S |     | T | R  |       |
|                                      | S |     | T | R  |       |
| 3. Miscellaneous Property in Section | S |     | T | R  |       |
|                                      | S |     | T | R  |       |

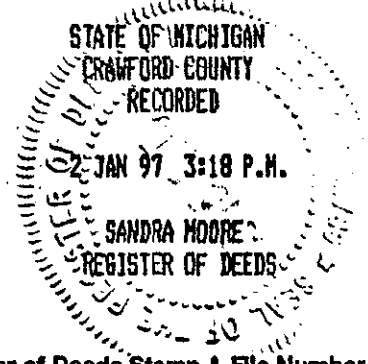

Register of Deeds Stamp & File Number

4. Lot No. \_\_\_\_\_, Recorded Plat \_\_\_\_\_  
5. Private Claims \_\_\_\_\_

**LIBER 3 PAGE 259**

I, Marvin E. Myers, in a field survey on December, 1995, do hereby certify that under requirements of P.A. 74, Michigan P.A. of 1970, the corner points mentioned in lines 1 and 2 above were in conformance with regulations and rules therefore as required in the current manual of survey instructions of the United States Department of the Interior, Bureau of Land Management or by a decree of a Court of Law and/or that the corner points mentioned in lines 3, 4 and 5 above were in conformance with the rules of the Michigan Board of Professional Surveyors or by a Decree of a Court of Law; established, re-established, monumented, re-monumented, recovered, found as expressed below:

	A	B	C	D	E	F	G	H	I	J	K	L	M
2	6		5		4		3		2		1		
3													
4	7		6		5		4		3		2		1
5													
6	18		17		16		15		14		13		12
7													
8	19		20		21		22		23		24		25
9													
10	30		29		28		27		26		25		24
11													
12	31		32		33		34		35		36		35
13													

**NOTE: Not more than 4 corners, all in the same town and range, may be recorded on this certificate.**

**A. Description of original monument and accessories and/or subsequent restoration:**

- |   |  |
|---|--|
| GLO-James H. Mullett April 1839<br>Mon.-Set Post<br>WIT: 10" S.Pine N27°N 40 lks.<br>9" S.Pine S27°E 8 lks. | Kenneth J. Ostling Mar. 1981<br>Mon.-4" Nail in M-72<br>WIT: 10" J.Pine S19°E 40.50'<br>12" J.Pine S43°W 63.80'  |
| George Henning Nov. 1956<br>Mon.-Iron Bolt<br>WIT: None   | G. Boss June 1988 Liber 280, pg. 40<br>Mon.-R.R. Spike in Mon. Box<br>WIT: Spike in 9" J.Pine N30°E 52.40'<br>Spike in 10" R.Pine S70°E 103.86'<br>Spike in 5" R.Pine S65°W 69.06'<br>C M-72 South 3.20' |

M.E. Myers *M 1 P 95*  
Mon.-Iron Bolt in Mon. Box  
WIT: Fd. NBT 8" J.Pine S30°E 40.50'  
Nail in NW face 5" R.Pine S50°W 71.10'  
Nail E. face 7" J.Pine N40°E 54.93'  
Nail E. face 7" R.Pine S60°E 102.86'  
Mon. Box N. 3.0'± C M-72  
Fd. 12" J.Pine stump S43°W 63.80'

**B. Description of corner evidence found and/or method applied in restoring or reestablishing corner:**

Monument - Square iron in monument box 3.5'± North of centerline of M-72  
WIT: Nail SW side 12" R.Pine S64°E 103.86'  
Nail SE side 12" J.Pine N44°E 52.38'  
Nail NW side 8" R.Pine S60°W 69.10'  
Fd 12" J. Pine Stump S43°W 63.80


Accepted as the best available evidence of the position of the Original Corner.

**CRAWFORD COUNTY  
PEER GROUP APPROVAL  
DATE June 17, 1998**

*Marvin E. Myers*  
**Marvin E. Myers, P.S.  
County Surveyor**

**C. Description of monument for corner and accessories established to perpetuate locating the position of the corner:**

Replaced square iron pin with standard Crawford County monument in pav't box  
Wit: Nail & tag Utility Pole N31°W 89.67  
Nail & tag 12" J. Pine N44°E 52.42  
Nail & tag 12' R. Pine S78°E 103.94  
Nail & tag 8" R. Pine S60°W 69.11  
3.2'± North of centerline M-72

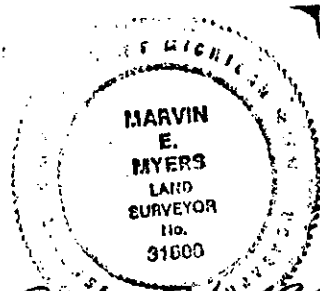

Signed by *Marvin E. Myers*  
Surveyor's Michigan License No. 31600

Date Dec 31, 1996