

SURVEY & REMONUMENTATION

MAY 05 1997

LAND CORNER RECORDATION CERTIFICATE
Filing Requirement of Act 74, Mich. P.A. 1970

For corners in COMMISSION
Crawford
 (County)

Located In:	Corner Code #
T 26N R 3W	I - 3
T _____ R _____	_____
T _____ R _____	_____
T _____ R _____	_____
S _____ T _____ R _____	_____
S _____ T _____ R _____	_____
S _____ T _____ R _____	_____
S _____ T _____ R _____	_____


STATE OF MICHIGAN
 CRAWFORD COUNTY
 RECORDED
 7 JUN 96 9:48 A.M.
 SANDRA MOORE
 REGISTER OF DEEDS

Register of Deeds Stamp & File Number

4. Lot No. _____, Recorded Plat _____
 5. Private Claims _____

LIBER 3 PAGE 237

I, Marvin E. Myers, in a field survey on December, 19 95, do hereby certify that under requirements of P.A. 74, Michigan P.A. of 1970, the corner points mentioned in lines 1 and 2 above were in conformance with regulations and rules therefore as required in the current manual of survey instructions of the United States Department of the Interior, Bureau of Land Management or by a decree of a Court of Law and/or that the corner points mentioned in lines 3, 4 and 5 above were in conformance with the rules of the Michigan Board of Professional Surveyors or by a Decree of a Court of Law; established, re-established, monumented, re-monumented, recovered, found as expressed below:

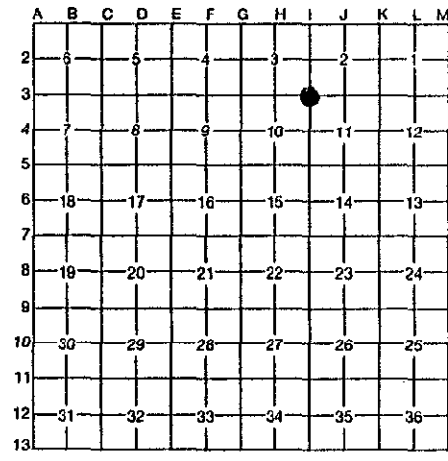

NOTE: Not more than 4 corners, all in the same town and range, may be recorded on this certificate.

A. Description of original monument and accessories and/or subsequent restoration:

- GLO-James Mullett 1839
 Mon.-Set Post
 WIT: 10" S.Pine N62°E 52 lks.
 8" S.Pine S34°W 32 lks.
- G. Henning June 1944
 Mon.-Fd. 1 1/2" Pipe in road
 WIT: NBT 12" J.Pine NE 82.50'
 10" J.Pine SE 108.90'
- G. Henning Nov. 1956
 Mon.-Fd. 1 1/2" Pipe
 BT marked 1944
 WIT: 12" J.Pine NE 82.50'
 10" J.Pine SE 108.90'
- C. Ostling Feb. 1964
 Mon.-1 1/2" Pipe
 WIT: 8" J.Pine N31°E 75.90'
 8" J.Pine S56°E 93.60'
- N. Parker June 1972 L.2, pg.91
 Mon.-1 1/2" Pipe
 WIT: Fd. old witnesses
 8" J.Pine N31°E 75.90'
 8" J.Pine S56°E 93.60'
- N. Parker Sept. 1977 L.164, pg.364
 Mon.-1 1/2" Pipe
 WIT: 8" J.Pine N31°E 75.90'
 8" J.Pine S56°E 93.60'
- Thomas M. Kelly Sept. 1978 L.175, pg.330
 Mon.-Fd. 2" Pipe
 WIT: 10" Pine N15°W 92.95'
 6" Pine N40°E 76.20'
 T.P. S75°W 32.00'
 P.P. #253/20/5 S38°E 45.60'
- N. Parker May 1982 L.206, pg.112
 Mon.-1 1/2" Pipe
 WIT: 8" J.Pine N31°E 75.90'
 8" J.Pine S56°E 93.60'
- N. Parker July 1986 L.247, pg.13
 Mon.-1 1/2" Pipe
 WIT: 10" J.Pine N31°E 75.90'
 10" J.Pine S56°E 93.60'
- G. Boss June 1988 L.280, pg.42
 Mon.-1 1/2" Pipe
 WIT: Spike U.Pole S70°W 31.88'
 Spike U.Pole S45°E 45.48'
 Nail 8" J.Pine N35°E 76.18'

B. Description of corner evidence found and/or method applied in restoring or reestablishing corner:


Monument - Found 1/2" Iron Bar over 1 1/2" I.D. Pipe in Mon. Box 1.80' W. of centerline Headquarters Rd.
 WIT: Found nail in NE side of 10" J. Pine N37°W 53.88'
 Nail with cap# 24599 in West side of 13" J.Pine N13°W 92.82'
 Blaze on SW side of 9" J.Pine N41°E 75.95'
 Nail with cap in SE side of 9" J.Pine N41°E 76.22'
 Nail with cap in NW side of Utility Pole S40°E 76.22'
 Nail with cap in SE side of Utility Pole S75°W 31.91' to Boss nail and cap 31.77'
 Centerline N-S road East 1.80'

C. Description of monument for corner and accessories established to perpetuate locating the position of the corner:

Mon.-Set standard Crawford County Monument stamped "I-3 T26N, R3W 31600" over 1 1/2" I.D. Pipe
 WIT: Nail NE side 10" J.Pine N39°W 53.90'
 Nail & Cap #24599 W. side 13" J.Pine N13°W 92.90'
 Blaze SW face 9" J.Pine N40°E 75.90'
 Nail & Cap #24599 SE side 9" J.Pine N40°E 76.26'
 Nail & Cap #24599 NW side U.P. S40°E 45.46
 Nail & Cap #24599 SE side U.P. S75°W 32.00'
 Boss Nail & Tag NW side U.P. S75°W 31.87'

CRAWFORD COUNTY
PEER GROUP APPROVAL
 DATE PIC 19, 1995

Marvin E. Myers
 Marvin E. Myers, P.S.
 County Surveyor

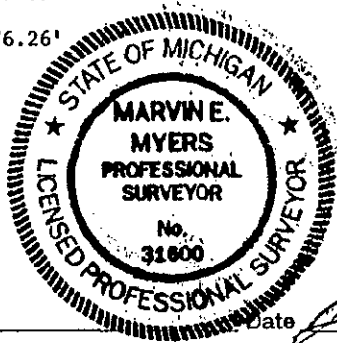

Signed by Marvin E. Myers
 Surveyor's Michigan License No. 31600

Date June 6, 1995