


**SURVEY & REMONUMENTATION**

MAY 05 1997

**LAND CORNER RECORDATION CERTIFICATE**  
Filing Requirement of Act 74, Mich. P.A. 1970

For corners in **COMMISSION**  
Crawford (County)

Located In:	Corner Code #
1. Public Land Survey T 26N R 3W	I - 5
T R	
T R	
T R	
2. Property Controlling S T R	
S T R	
3. Miscellaneous S T R	
S T R	

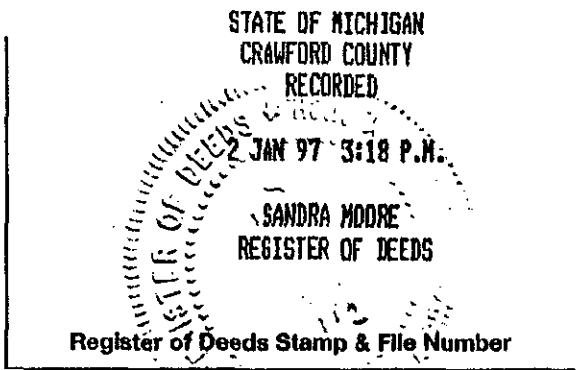

4. Lot No. \_\_\_\_\_, Recorded Plat \_\_\_\_\_  
5. Private Claims \_\_\_\_\_

**LIBER 3 PAGE 260**

I, Marvin E. Myers, in a field survey on December, 1995, do hereby certify that under requirements of P.A. 74, Michigan P.A. of 1970, the corner points mentioned in lines 1 and 2 above were in conformance with regulations and rules therefore as required in the current manual of survey instructions of the United States Department of the Interior, Bureau of Land Management or by a decree of a Court of Law and/or that the corner points mentioned in lines 3, 4 and 5 above were in conformance with the rules of the Michigan Board of Professional Surveyors or by a Decree of a Court of Law; established, re-established, monumented, re-monumented, recovered, found as expressed below:

	A	B	C	D	E	F	G	H	I	J	K	L	M
2	6	5	4	3	2								
3													
4	7	8	9	10	11	12							
5													
6	18	17	16	15	14	13							
7													
8	19	20	21	22	23	24							
9													
10	30	29	28	27	26	25							
11													
12	31	32	33	34	35	36							
13													

**NOTE: Not more than 4 corners, all in the same town and range, may be recorded on this certificate.**

**A. Description of original monument and accessories and/or subsequent restoration:**

- GLO-James Mullett 1839 N. Parker Oct. 1979 G. Boss: June 1988 Liber 280, pg. 41
- Mon.-Set Post Mon.-Fd. 1/2" Bar Mon.-R.R. Spike fd. in Mon. Box 5.5
- WIT: 9" S.Pine N09°W 12 lks. WIT: Fd. old Witnesses North of C M-72
- 12" S.Pine S14 1/2°E 65 lks. J.Pine stump NW 50.10' WIT: Spike in U.Pole N25°E 76.58'
- George D. Henning Nov. 1956 J.Pine (now gone) NE 55.30' Spike in U.Pole N20°W 75.88'
- Mon.-3/4" Pipe in road centers MDSH Mon. Box N02°E 5.25' Spike in 11" J.Pine S40°W 53.14'
- WIT: 5" J.Pine NW 50.10' P.Pole N20°E 101.00'
- 10" J.Pine NE 55.30' 8" N.Pine S30°E 62.80'
- 12" J.Pine S40°W 42.50'

**B. Description of corner evidence found and/or method applied in restoring or reestablishing corner:**

Found 60D nail over 1/2" iron pipe and found 8" (now 13" N. Pine S30°E 62.80' Accepted as the best available evidence of the position of the Original Corner

RR Spike in Mon.Box 5.5 North of Center line of M-72 was not accepted.

**CRAWFORD COUNTY PEER GROUP APPROVAL**  
DATE JUNE 17, 1996  
*Marvin E. Myers*  
**Marvin E. Myers, P.S. County Surveyor**

**C. Description of monument for corner and accessories established to perpetuate locating the position of the corner:**

- Set Standard Crawford County Monument in Pav't box
- Wit: Nail & tag in Utility Pole N29°E 81.62
- Nail & tag in Utility Pole N16°W 80.25
- Nail & tag in 11" J. Pine S23°W 48.68
- Nail & tag in 13" R. Pine S32°E 62.85
- RR Spike in Mon.Box 5.5 North of centerline of M-72



Signed by *Marvin E. Myers* Date Dec 31, 1996