

SURVEY & REMONUMENTATION

APR 07 1998

LAND CORNER RECORDATION CERTIFICATE
 Filing Requirement of Act 74, Mich. P.A. 1970

For corners in SECTION

Crawford
 (County)

Located in:

Corner Code #

1. Public Land Survey

T 26N R 2W
 T 27N R 2W
 T 27N R 3W
 T 26N R 3W

A-1
 A-13
 M-13
 M-01

2. Property Controlling in Section

S T R
 S T R

3. Miscellaneous Property in Sec.

S T R
 S T R

4. Lot No. _____, Recorded Plat _____

5. Private Claims _____

LIBER

STATE OF MICHIGAN
 CRAWFORD COUNTY
 RECORDED

19 DEC 97 2:36 P.M.

SANDRA MOORE
 REGISTER OF DEEDS

Register of Deeds Stamp & File Number

3 PAGE 281

I, Marvin E. Myers, in a field survey on 27 MAY, 1997 do hereby state that under requirements of P.A. 74, Michigan P.A. of 1970, the corner points mentioned in lines 1 and 2 above were in conformance with regulations and rules therefore as required in the current manual of survey instructions of the United States Department of the Interior, Bureau of Land Management or by a decree of a Court of Law and /or that the corner points mentioned in lines 3, 4 and 5 above were in conformance with the rules of the Michigan Board of Land Surveyors or by a Decree of a Court of Law; established, re-established, monumented, recovered, found as expressed below:

NOTE: Not more than 2 corners, all in the same town and range, may be recorded on this certificate.

A. Description of original monument and accessories and/or subsequent restoration:

G.L.O. 15 June 1852 Darwin A. Pettibone D.S. Mon: Post Wit: 24" Pine S71°W 1.00 links 18" Yellow Pine N80°E 1.29' links 12" White Pine N18°W 0.94 links	1955 George D. Henning R.L.S. Unrecorded Survey Sec.6 T26N R2W Restored from stumps of original U.S. witnesses Mon: 3/4" square bar in blacktop 9' N. of centerline Wit: 4' Jack Pine N58°W 58.1 8' Jack Pine N41°E 37.00' 7' Jack Pine S31°W 62.0'
---	---

	A	B	C	D	E	F	G	H	I	J	K	L	M
1													
2	6		5		4		3		2		1		
3													
4	7		8		9		10		11		12		
5													
6	18		17		16		15		14		13		
7													
8	19		20		21		22		23		24		
9													
10	30		29		28		27		26		25		
11													
12	31		32		33		34		35		36		
13													

Robert T. Ostling R.L.S.#5133
 Liber 1 Page 59, 14 August 1959
 Plat of Ausable Trails
 Mon: 3/4" Iron in pavement
 Wit: none provided

Eugene Ostling R.L.S.#12026 Unrecorded survey, 4 Sept 1971 Mon: 3/4" square iron Wit: none provided	Norman F. Parker R.L.S.#16939 Liber 148 Page 07, 26 Sept 1975 Mon: no description provided Wit: none provided
--	--


Norman F. Parker R.L.S.#12026
 Unrecorded survey 29 Dec 1986
 Mon: no description provided
 Wit: none provided

B. Description of corner evidence found and/or method applied in restoring or reestablishing corner:
 Found Rail Road spike flush with the asphalt surface 8.5' north of centerline. Verified position by measurement to corners East and West. Accepted position as a perpetuation of the original government corner, replaced railroad spike in exact location with standard County Monument in pavement monument box.

C. Description of monument for corner and accessories established to perpetuate locating the position of the corner:
 Mon - Standard Crawford County monument in Pavement Monument box.

Wit: Spike in Southeast side Utility Pole S53°W 60.60'
 Set spike in West side 13" Red Pine S36°W 76.90'
 Set spike in East side 8" White Pine S38°E 87.60'
 Set spike in 8" Jack Pine N20°W 43.63'

CRAWFORD COUNTY
PEER GROUP APPROVAL
 DATE OCT 16, 1997

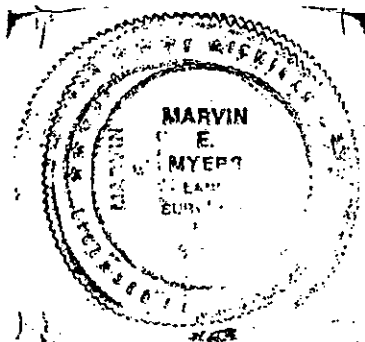

Marvin E. Myers
 Marvin E. Myers, P.S.
 County Surveyor

Signed by *Marvin E. Myers*
 Surveyor's Michigan License No. 31600

Date Dec 15, 1997