

SURVEY & REMONUMENTATION

APR 07 1998

SECTION LAND CORNER RECORDATION CERTIFICATE
Filing Requirement of Act 74, Mich. P.A. 1970

For corners in

Crawford Located In: Corner Code #
 (County)

1. Public Land Survey T 26N R 2W A-3
 T ~~26N~~ R 3W M-3
 T _____ R _____
 T _____ R _____

2. Property Controlling S _____ T _____ R _____
 In Section S _____ T _____ R _____

3. Miscellaneous S _____ T _____ R _____
 Property In Sec. S _____ T _____ R _____

4. Lot No. _____, Recorded Plat _____

5. Private Claims _____ **LIBER**

STATE OF MICHIGAN
 CRAWFORD COUNTY
 RECORDED
 19 DEC 97 2:37 P.M.
 SANDRA MOORE
 REGISTER OF DEEDS
 Register of Deeds Stamp & File Number

3 PAGE 288

I, Marvin E. Myers, in a field survey on 27 MAY, 1997 do hereby state that under requirements of P.A. 74, Michigan P.A. of 1970, the corner points mentioned in lines 1 and 2 above were in conformance with regulations and rules therefore as required in the current manual of survey instructions of the United States Department of the Interior, Bureau of Land Management or by a decree of a Court of Law and/or that the corner points mentioned in lines 3, 4 and 5 above were in conformance with the rules of the Michigan Board of Land Surveyors or by a Decree of a Court of Law; established, re-established, monumented, recovered, found as expressed below:

	A	B	C	D	E	F	G	H	I	J	K	L
1												
2	6		5		4		3		2			
3												
4	7		8		9		10		11			
5												
6	18		17		16		15		14			
7												
8	19		20		21		22		23			
9												
10	30		29		28		27		26			
11												
12	31		32		33		34		35			
13												

NOTE: Not more than 2 corners, all in the same town and range, may be recorded on this certificate.

A. Description of original monument and accessories and/or subsequent restoration:

G.L.O. George D. Henning R.L.S.
 15 June 1852 Liber 1 Page 37, 1945
 Darwin A. Pettibone D.S. Plat of Thendara
 Mon: Post' Mon: no description provided
 Wit: none provided

George D. Henning R.L.S. Norman F. Parker R.L.S.#16939
 Unrecorded Survey Sec.1 T26N R3W Oct 1955 Liber 184 Page 260, 24 December 1979
 Mon: Found tile filled with concrete (by Delamatar) Mon: No description provided
 Wit: 5" Jack Pine N62°E 15.6' Wit: None provided
 5" Jack Pine S57°E 28.8'


George D. Henning R.L.S.
 Unrecorded Survey Sec.6 T26N R2W 1955
 Mon: Found tile filled with concrete
 Wit: none provided

B. Description of corner evidence found and/or method applied in restoring or reestablishing corner:
 Found clay tile filled with concrete; found dead 14" Jack Pine with blaze N20°E 39.85"
 Accepted as the best available evidence of the position of the Original Corner.
 Replaced with Standard Crawford County Monument.

C. Description of monument for corner and accessories established to perpetuate locating the position of the corner:
 Mon - Standard Crawford County Monument
 Wit; Set spike in West side 4" J. Pine North 8.40'
 Set spike in North side 12" J. Pine N88°W 49.58'
 Set spike in North side 10" Balsam S75°E 15.55'
 Set spike in South side 14" Red Pine N66°E 80.60'

CRAWFORD COUNTY
PEER GROUP APPROVAL
 DATE OCT 16, 1997

Marvin E. Myers
 Marvin E. Myers, P.S.
 County Surveyor

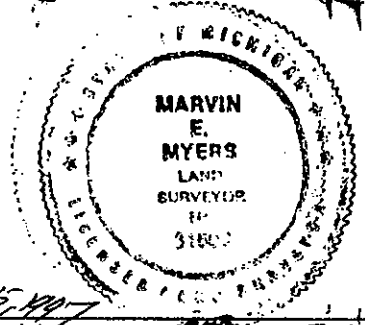

Signed by *Marvin E. Myers*
 Surveyor's Michigan License No. 31600

Date Dec 15, 1997