SURVEY & REGISTRATION

MAR 29 2000

SECTION

LIBER 4 PAGE 60

LAND CORNER RECORDATION CERTIFICATE
Filing Requirement of Act 74, Mich. P.A. 1970

For corners in

CRAWFORD (County)

	Located In:	Corner Code #
1. Public Land Survey	T 26N R 2W	A-12
	T 26N R 3W	M-12
	T ____ R ____	
	T ____ R ____	
2. Property Controlling	S ____ T ____ R ____	
in Section	S ____ T ____ R ____	
3. Miscellaneous	S ____ T ____ R ____	
Property in Sec.	S ____ T ____ R ____	

STATE OF MICHIGAN
CRAWFORD COUNTY
RECORDED

13 DEC 99 9:49 A.M.

SANDRA MOORE
REGISTER OF DEEDS

Register of Deeds Stamp & File Number

4. Lot No. _____ , Recorded Plat _____
5. Private Claims_____

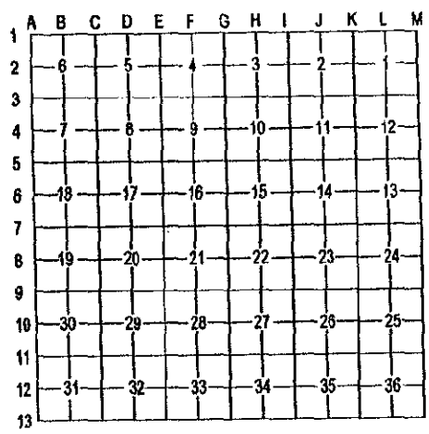

I, Marvin E. Myers , in a field survey on 16 SEPTEMBER , 1999 do hereby state that under requirements of P.A. 74, Michigan P.A. of 1970, the corner points mentioned in lines 1 and 2 above were in conformance with regulations and rules therefore as required in the current manual of survey instructions of the United States Department of the Interior, Bureau of Land Management or by a decree of a Court of Law and /or that the corner points mentioned in lines 3, 4 and 5 above were in conformance with the rules of the Michigan Board of Land Surveyors or by a Decree of a Court of Law, established, re-established, monumented, recovered, found as expressed below:

NOTE: Not more than 2 corners, all in the same town and range, may be recorded on this certificate.

A. Description of original monument and accessories and/or subsequent restoration:

G.L.O - 1839
James H. Mullet, D.S.
Mon. - Post
10" Pine S48°W 17 links
6" Pine N39°W 20 links

C. Eugene Ostling, R.L.S.# 12026
Unrecorded survey dated 1970
Mon: Found bottom of post, reset 1/2" x 18" bar.
Wit: None provided

Norman F. Parker, R.L.S.#16939
LCRC (Liber 2, Page 65) 1976
Mon: Found 1/2" Bar
Wit: 12" Oak S67°W 25.00'
12" Oak N38°E 66.9'
Face of Power Pole N26°W 44.9'

11-05-1996 R. Mitchcell # 28417
Mon – Found 1½" Pipe with ½" rerod set beside
Wit: Set pk & tag NE side 20" Oak N60°W 55.30
Set Pk & tag S. side 12" J. Pine N89°E 44.30
Fd. Pk nail S. side PP N26°W 45.10
Set Pk & tag W. side 8" J. Pine S0°E 40.9

B. Description of corner evidence found and/or method applied in restoring or reestablishing corner:

Found 1/2" x 18" bar and 2" x 2" wood hub 40' South of trail Road.
Found 12" Oak S62°W 25.0'
Found Utility Pole N26°W 45.0'
Found M&L tag #28417 in North face 14" Oak N60°W 55.39'
Found M&L tag #28417 in South face 12" Jack Pine N88°W 44.16'
Found M&L tag #28417 in West face 12" Jack Pine South 40.95'
Accepted ½" bar as the best available evidence of the position of the Original Corner, replaced bar with Standard County Monument.

C. Description of monument for corner and accessories established to perpetuate locating the position of the corner:

Mon: Set a Standard County Corner
Wit: Set Spike in East Face 8" Twin Jack Pine N22°E 4.75'
Set Spike in Northwest face 12" Oak S62°W 25.08'
Found P.K. nail in Southeast face of Utility Pole N26°W 44.90'
M&L tag #28417 in South face 12" Jack Pine N88°W 44.16'
M&L tag #28417 in West face 12" Jack Pine South 40.95'
Set Carsonite Post 1' East
M&L tag #28417 in North side 14" Oak N60°W 55.39'

CRAWFORD COUNTY
PEER GROUP APPROVAL
DATE Nov 30, 1999
Marvin E. Myers MEM
Marvin E. Myers, P.S.
County Surveyor

Signed by _____
Surveyor's Michigan License No. 31600

STATE OF MICHIGAN
MARVIN E. MYERS
PROFESSIONAL SURVEYOR
No. 31600
LICENSED PROFESSIONAL SURVEYOR

Date Dec 06, 1999

FORM APPROVED BY MICHIGAN STATE BOARD OF PROFESSIONAL SURVEYORS, JAN. 28,
REVISED MAY 14,
REVISED JAN.,
REVISED OCT.,