

LAND CORNER RECORDATION CERTIFICATE

FILING REQUIREMENT OF ACT 74, MICH. P.A.1970

FOR CORNERS OF--	LOCATED IN--	CORNER CODE NUMBER
1. PUBLIC LAND SURVEY	T. 26 N. R. 3 E.	L-8; L-9; L-10; L-11
2. PROPERTY CONTROLLING IN SECTION	T. S. R. E. W.	
3. MISCELLANEOUS PROPERTY IN SECTION	T. S. R. E. W.	
4. LOT NO.	RECORDED PLAT	
5. PRIVATE CLAIMS		

REGISTER OF DEEDS STAMP AND FILING NUMBER

I, Carl R. Johnson, do hereby certify that under requirements of P.A. 74, Michigan P.A. of 1970, the corner points mentioned in lines 1 and 2 above were, in a field survey on April 11, 1985, established, re-established, monumented, re-monumented, recovered or restored as expressed below and in conformance with regulations and rules therefore as required in the current manual of survey instructions of the United States Department of the Interior, Bureau of Land Management or by a decree of a court of law. Furthermore, that the corner points mentioned in lines 3, 4 and 5 above were, in a field survey on _____, 19____, found, recovered, restored, established or re-established as expressed below and in conformance with the rules of the Michigan State Board of Registration for Land Surveyors or, by a Decree of a Court of law:

C. Continued:

L-10	L-11
Set 5/8" bar w/cap & cedar post	Set DNR monument
6" Jack Pine N31°E 17.0'	9" Jack Pine N42°E 69.0'
8" Jack Pine N58°W 27.0'	6" Jack Pine N40°W 71.9'
Fd 1½" x 1½" Stake S30°E 1.5'	1½" Pipe (Lot corner) S4°W 34.8'

B. Description of corner evidence found and/or method applied in restoring or re-establishing corner:


- L-8 - Set on computed true intersection of ¼ lines.
- L-9 - Set midway and on line between found section corners. No evidence of original or subsequent surveys.
- L-10 - Set at computed true intersection of ¼ lines.
- L-11 - Set at a point which is the apparent location used in previous local surveys.

C. Description of monument for corner and accessories established to perpetuate locating the position of the corner:

L-8	L-9
Set 5/8" bar w/cap & cedar post	Set DNR mon & cedar post
4" Red Oak N78°W 12.4'	6" Jack Pine N28°E 20.3'
5" Red Oak N84°E 11.8'	7" Red Oak S80°W 9.2'

SIGNED BY Carl R. Johnson DATE 4/2/86

SURVEYOR'S MICHIGAN REGISTRATION NO. 30083

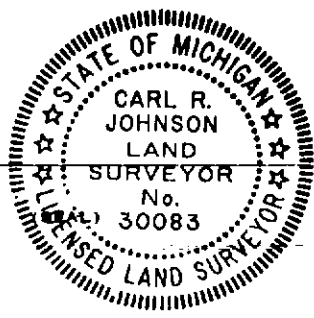

FOR STATE AND UNITED STATES AGENCIES:

SIGNED BY _____ DATE _____
CHIEF OF SURVEY PARTY

APPROVED AND SIGNED BY _____ DATE _____
MICHIGAN REGISTERED LAND SURVEYOR

SURVEYOR'S MICHIGAN REGISTRATION NO. _____ CRAWFORD COUNTY