

APR 07 1998

SECTION

LAND CORNER RECORDATION CERTIFICATE
Filing Requirement of Act 74, Mich. P.A. 1970

For corners in

<u>Crawford</u> (County)	Located In:	Corner Code #
1. Public Land Survey	Sec. 32T <u>26</u> N R <u>4</u> W	<u>D-13</u>
	Sec. 5 T <u>25</u> N R <u>4</u> W	<u>D-1</u>
	T _____ R _____	_____
	T _____ R _____	_____
2. Property Controlling in Section	S _____ T _____ R _____	_____
	S _____ T _____ R _____	_____
3. Miscellaneous Property in Sec.	S _____ T _____ R _____	_____
	S _____ T _____ R _____	_____

STATE OF MICHIGAN
CRAWFORD COUNTY
RECORDED

19 DEC 97 2:38 P.M.

SANDRA MOORE
REGISTER OF DEEDS

Register of Deeds Stamp & File Number

4. Lot No. _____, Recorded Plat LIBER 3

5. Private Claims _____

PAGE 293

	A	B	C	D	E	F	G	H	I	J	K	L	M
1													
2	6		5		4		3		2		1		
3													
4	7		8		9		10		11		12		
5													
6	10		17		16		15		14		13		
7													
8	19		20		21		22		23		24		
9													
10	30		29		28		27		26		25		
11													
12	31		32		33		34		35		36		
13													

I, Marvin E. Myers, in a field survey on September, 1997 do hereby state that under requirements of P.A. 74, Michigan P.A. of 1970, the corner points mentioned in lines 1 and 2 above were in conformance with regulations and rules therefore as required in the current manual of survey instructions of the United States Department of the Interior, Bureau of Land Management or by a decree of a Court of Law and/or that the corner points mentioned in lines 3, 4 and 5 above were in conformance with the rules of the Michigan Board of Land Surveyors or by a Decree of a Court of Law; established, re-established, monumented, recovered, found as expressed below:

NOTE: Not more than 2 corners, all in the same town and range, may be recorded on this certificate.

A. Description of original monument and accessories and/or subsequent restoration:

G.L.O. April 16, 1839 H. Brevoort D.S. & James H. Mullet D.S. Mon: Post Wit: 20" Yellow Pine N03°W 30 links 16" Yellow Pine N44°E 50 links	Michigan Department of Conservation Billy D. Buckley R.L.S July 31, 1957 Corner established by proportionate measurement between section corners. Mon: 1" pipe with 4" brass cap Wit: 7" White Oak S04°W 14 1/2 links 10" White Oak N72°W 38 1/2 links
--	---


CRAWFORD COUNTY
PEER GROUP APPROVAL
DATE OCT 16, 1997

Marvin E. Myers
Marvin E. Myers, P.S.
County Surveyor

B. Description of corner evidence found and/or method applied in restoring or reestablishing corner:
Found Conservation Department Monument in impact area of Range 13 Complex. Replace in exact location with Standard Crawford County Monument. Accepted as a reestablishment of the position of the Original government Corner

C. Description of monument for corner and accessories established to perpetuate locating the position of the corner:

Mon - Standard Crawford County Monument.
Set nail & tag in E. side 6" White Oak N48°E 93.28'
Set nail & tag in N. side 10" Black Oak S80°E 93.31'
Set nail & tag in W. Side 3" Black Oak S33°E 76.93'
Set nail & tag in N. side 6" Black Oak N63°W 51.96'
Set Carsonite Post East 0.6'

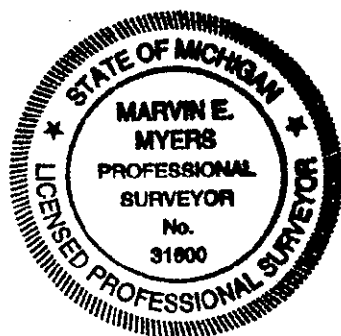

Signed by *Marvin E. Myers*
Surveyor's Michigan License No. 31600

Date OCT 23, 1997