SURVEY & REMONUMENTATION

APR 07 1998

LAND CORNER RECORDATION CERTIFICATE
Filing Requirement of Act 74, Mich. P.A. 1970

For corners in SECTION

Crawford (County)

STATE OF MICHIGAN
CRAWFORD COUNTY
RECORDED

19 DEC 97 2:40 P.M.

SANDRA MOORE
REGISTER OF DEEDS

Register of Deeds Stamp & File Number

LIBER 3 PAGE 301

	Located In:	Corner Code #
1. Public Land Survey	T 26N R 4W	L-13
	T 25N R 4W	L-1
	T___ R___	
	T___ R___	
2. Property Controlling	S___ T___ R___	
In Section	S___ T___ R___	
3. Miscellaneous	S___ T___ R___	
Property in Sec.	S___ T___ R___	

4. Lot No. _____ , Recorded Plat _____
5. Private Claims _____

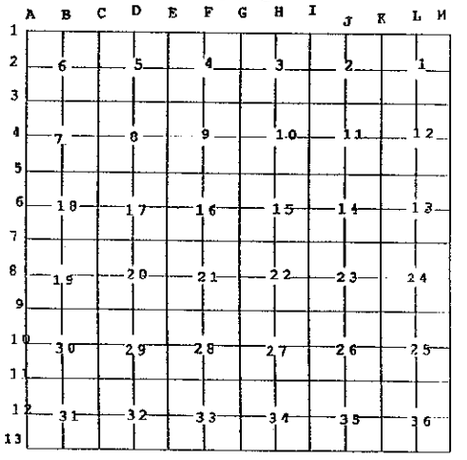

I, Marvin E. Myers, in a field survey on September, 19 97 do hereby state that under requirements of P.A. 74, Michigan P.A. of 1970, the corner points mentioned in lines 1 and 2 above were in conformance with regulations and rules therefore as required in the current manual of survey instructions of the United States Department of the Interior, Bureau of Land Management or by a decree of a Court of Law and /or that the corner points mentioned in lines 3, 4 and 5 above were in conformance with the rules of the Michigan Board of Land Surveyors or by a Decree of a Court of Law; established, re-established, monumented, recovered, found as expressed below:

NOTE: Not more than 2 corners, all in the same town and range, may be recorded on this certificate.

A. Description of original monument and accessories and/or subsequent restoration:

G.L.O.
April 16, 1839
H. Brevoort D.S. &
James H. Mullet D.S.
Mon: Post
Wit: 10" Beech N62°W 22 links
12" Beech N60°E 07 links

Robert T. Ostling
Dec. 1960
No description provided

Norman F. Parker R.L.S. #16939
1983 Liber 244 Page 503
Mon: 1/2" iron bar cap #16939

Note: Ostling Dec 1960 work map indicates ½x18" bar & cap set midway & on line
Wit: 15" Oak N28°20'W 57.9
8" Maple N12°50'E 45.5
14" Poplar S14°50'W 51.8

Norman F. Parker R.L.S. #16939
1983 Liber 217 Page 108
Mon: 1/2" iron bar cap #16939
Wit: Old Blaze 24" Oak N24°W 57.6'
Old Blaze 12" Maple N17°E 45.5'
Old Blaze 18" Poplar S19°W 51.6'

Norman F. Parker R.L.S. #16939
1983 Liber 217 Page 624
Mon: 1/2" iron bar cap #16939

CRAWFORD COUNTY
PEER GROUP APPROVAL
DATE OCT 16, 1997
Marvin E. Myers MEM
Marvin E. Myers, P.S.
County Surveyor

Marvin E. Myers P.S. #31600 June 11, 1990
Mon: Found 1/2" bar and cap of record
Wit: Nail in SE face 6" poplar S45°W 57.2
Nail in NE face 22" R. Oak N24°W 58.6
Nail in NW face 9" Maple N16°E 45.6
20" Poplar N16°E 52.3

B. Description of corner evidence found and/or method applied in restoring or reestablishing corner:

Found 1/2" iron bar cap #16939, replace ½"x6" bar & cap with Standard Crawford County Monument.
Found Old Blaze with spike 24" Oak N24°W 57.6'
Found Old Blaze with spike 12" Maple N17°E 45.5'
Found Old Blaze with spike 18" Poplar S19°W 51.6'
Accepted position as the best available evidence of the position of the Original Corner.

C. Description of monument for corner and accessories established to perpetuate locating the position of the corner:
Mon - Standard Crawford County Monument in pavement monument box.
Wit: Set nail & tag NW side 10" Oak Az 248° 64.81
Set nail & tag SW side 6" Maple Az 138° 51.16
Found nail in NW side 9" Maple N16°E 45.6
Carsonite Post North 27±

Signed by Marvin E. Myers Date 12-3, 1997

Surveyor's Michigan License No. 31600

STATE OF MICHIGAN
MARVIN E. MYERS
PROFESSIONAL SURVEYOR
No. 31600
LICENSED PROFESSIONAL SURVEYOR

FORM APPROVED BY MICHIGAN STATE BOARD OF PROFESSIONAL SURVEYORS, JAN. 28, 197
REVISED MAY 14, 197
REVISED JAN., 198
REVISED OCT., 199