

SURVEY & REMONUMENTATION

APR 07 1998

LAND CORNER RECORDATION CERTIFICATE
Filing Requirement of Act 74, Mich. P.A. 1970

For corners in **SECTION**

Crawford Located In: Corner Code #
(County)

1. Public Land Survey
 ✓ T 26N R 4W (M-13)
 ✓ T 25N R 4W (M-1)
 ✓ T 26N R 3W (A-13)
 ✓ T 25N R 3W (A-1)

2. Property Controlling
 in Section S ___ T ___ R ___
 S ___ T ___ R ___

3. Miscellaneous
 Property in Sec. S ___ T ___ R ___
 S ___ T ___ R ___

STATE OF MICHIGAN
CRAWFORD COUNTY
RECORDED
19 DEC 97 2:38 P.M.
SANDRA MOORE
REGISTER OF DEEDS
Register of Deeds Stamp & File Number

4. Lot No. _____, Recorded Plat **LIBER**
5. Private Claims _____

3 PAGE 290

	A	B	C	D	E	F	G	H	I	J	K	L	M
1													
2	6		5		4		3		2		1		
3													
4	7		8		9		10		11		12		
5													
6	18		17		16		15		14		13		
7													
8	19		20		21		22		23		24		
9													
10	30		29		28		27		26		25		
11													
12	31		32		33		34		35		36		
13													

I, Marvin E. Myers, in a field survey on September, 19 97 do hereby state that under requirements of P.A. 74, Michigan P.A. of 1970, the corner points mentioned in lines 1 and 2 above were in conformance with regulations and rules therefore as required in the current manual of survey instructions of the United States Department of the Interior, Bureau of Land Management or by a decree of a Court of Law and /or that the corner points mentioned in lines 3, 4 and 5 above were in conformance with the rules of the Michigan Board of Land Surveyors or by a Decree of a Court of Law; established, re-established, monumented, recovered, found as expressed below:

NOTE: Not more than 2 corners, all in the same town and range, may be recorded on this certificate.

A. Description of original monument and accessories and/or subsequent restoration:
 G.L.O. Robert T. Ostling R.L.S., December 1960
 April 16 1839 Unrecorded survey
 H. Brevoort D.S. & Mon: no description provided
 James H. Mullet D.S. Wit: no witnesses provided;
 Post corner of Towns 25&26 Tie to N 1/4 corner with a distance of 2624.4' provided.
 18" yellow pine S20W 35 Links
 10" Yellow Pine S34E 25 Links

Norman F. Parker Marvin E. Myers
 R.L.S. # 16939 P.S.#31600
 Liber 1 Page 175, 28 March 1972 Liber 312 Page 305, 2 February, 1994
 Mon: P.K. nail in pavement over 1 1/4" pipe Mon: PK. Nail of record
 Wit: Face Power Pole N38°W 43.5'
 Face Power Pole S53°W 56.8'

CRAWFORD COUNTY
PEER GROUP APPROVAL
DATE OCT 16, 1997


Marvin E. Myers
Marvin E. Myers, P.S.
County Surveyor

B. Description of corner evidence found and/or method applied in restoring or reestablishing corner:

Found Rail Road spike 0.15' below pavement surface. 2.5 North of the intersection of the centerline of West Four Mile Road and South Oak Road Power poles of previous record have been removed. Measured distance to North 1/4 corner (2624.88(m)) and compared to Ostling's record distance (2624.40'(R)) Accepted position as the best available evidence of the position of the Original Corner.

C. Description of monument for corner and accessories established to perpetuate locating the position of the corner:

Mon - Standard Crawford County monument in pavement monument box.
 Wit: Set nail & tag in E. side 18" Oak Az. 29° 64.92
 Set nail & tag in W side 6" Maple Az. 164° 72.39
 Set nail & tag NW side Utility Pole Az. 243° 64.61
 Set nail & tag SW side 12" Oak (clump) Az. 320° 83.36

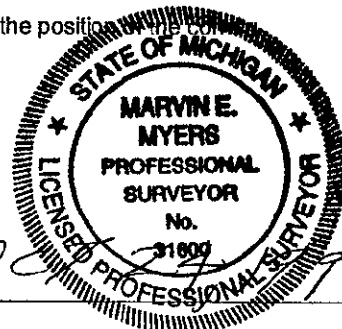

Signed by *Marvin E. Myers*
 Surveyor's Michigan License No. 31600

Date 10/16/97