

LAND CORNER RECORDATION CERTIFICATE

FILING REQUIREMENT OF ACT 74, MICH. P.A.1970

| FOR CORNERS OF --: | LOCATED IN --: | CORNER CODE NUMBER |
|--|-------------------------------|--------------------|
| 1. PUBLIC LAND SURVEY _____ | T. 26 N. R. 4 | A-3 |
| 2. PROPERTY CONTROLLING IN SECTION 7 _____ | T. 26 N. R. 4 | 3; 4 |
| 3. MISCELLANEOUS PROPERTY IN SECTION _____ | T. _____ N. S. R. _____ E. W. | |
| 4. LOT NO. _____, RECORDED PLAT _____ | | |
| 5. PRIVATE CLAIMS _____ | | |

REGISTER OF DEEDS STAMP AND FILING NUMBER

I, Kenneth J. Ostling, do hereby certify that under requirements of P.A. 74, Michigan P.A. of 1970, the corner points mentioned in lines 1 and 2 above were, in a field survey on November 14, 1978, established, re-established, monumented, re-monumented, recovered or restored as expressed below and in conformance with regulations and rules therefore as required in the current manual of survey instructions of the United States Department of the Interior, Bureau of Land Management or by a decree of a court of law. Furthermore, that the corner points mentioned in lines 3, 4 and 5 above were, in a field survey on _____, 19____, found, recovered, restored, established or re-established as expressed below and in conformance with the rules of the Michigan State Board of Registration for Land Surveyors or, by a Decree of a Court of law:

A. Description of original monument and accessories and/or subsequent restoration:


B. Description of corner evidence found and/or method applied in restoring or re-establishing corner:
 Found G.F. DeLaMater corner in place as established in 1943 survey. Used in previous surveys in this township retracement, and in subdivision of Sec. 1 26-5W.

- 3 Corner set by standard survey procedure for the subdivision of sections.
- 4 Set by standard survey procedure for the subdivision of sections.

C. Description of monument for corner and accessories established to perpetuate locating the position of the corner:

| A-3 | 3 | 4 |
|-----------------------------------|-------------------------------------|------------------------------------|
| Set DNR Mon. in place of 1/2" rod | Set 5/8" Rod w/RLS Cap & Cedar Post | Set 5/8" Rod w/RLS Cap & Ced. Post |
| 6" J. Pine S58°E 40.1 | | 6" J. Pine S65°E 46.64 |
| 5" J. Pine N62°E 33.75 | 6" J. Pine S62°W 35.3 | 8" J. Pine N26°E 66.15 |
| GFD Dead 14" J. Pine S37°E 112.7 | 6" Tw. J. Pine N54°W 3.2 | |
| GDH 6" J. Pine S56°E 71.9 | | |
| GDH 6" J. Pine N61°E 72.05 | | |

SIGNED BY Kenneth J. Ostling DATE 12-5-78
 SURVEYOR'S MICHIGAN REGISTRATION NO. 10068

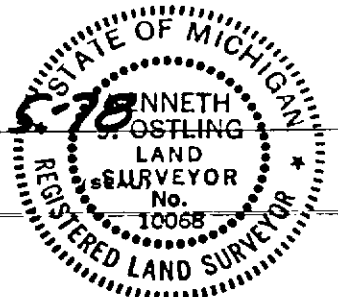

FOR STATE AND UNITED STATES AGENCIES:

SIGNED BY _____ DATE _____
CHIEF OF SURVEY PARTY
 APPROVED AND SIGNED BY _____ DATE _____
MICHIGAN REGISTERED LAND SURVEYOR (SEAL)

SURVEYOR'S MICHIGAN REGISTRATION NO. _____ CRAWFORD COUNTY