

LAND CORNER RECORDATION CERTIFICATE

Filing Requirement of Act 74, Mich. PA 1970

For Corners In:
Crawford
 (County)

		Located In		Corner Code #
1. Public Land Survey		T <u>26N</u>	R <u>4W</u>	<u>I-3</u>
		T _____	R _____	_____
2. Property Controlling in Section	S <u>10</u>	T <u>26N</u>	R <u>4W</u>	<u>9</u>
	S _____	T _____	R _____	_____
3. Miscellaneous Property in Section	S _____	T _____	R _____	_____
	S _____	T _____	R _____	_____


4. Lot No: _____ Recorded Plat: _____

5. Private Claims: _____

I, Carl T. Kiiskila, in a field survey on January 19, 2001 do hereby state that under requirements of PA 74, Michigan PA of 1970, the corner points mentioned in lines 1 and 2 above were in conformance with regulations and rules therefore as required in the current manual of survey instructions of the United States Department of the Interior, Bureau of Land Management or by a decree of a Court of Law and/or that the corner points mentioned in lines 3, 4 and 5 above were in conformance with the rules of the Michigan Board of Land Surveyors or by a Decree of a Court of Law; established, re-established, monumented, recovered, found as expressed below:

NOTE: Not more than 2 corners, all in the same town and range, may be recorded on this certificate.

Register of Deeds Stamp & File Number

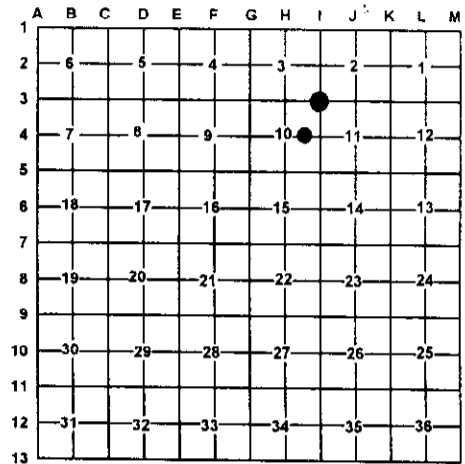

A. Description of original monument and accessories and/or subsequent restoration:

<p>9- Norman F. Parker R.L.S. #16939 Certificate of Survey L. 160, P. 421 November 1970 shows concrete monument for the NE corner of the NW quarter of the SE quarter of Sec. 10 T.26N.,R.4W.</p>	<p>I-3 G.L.O. Addison P. Brewer D.S. 1852 W. Oak 12" dia. corner of sections 2,3,10 and 11 Wit: W. Oak 9 N61.5°E 21 links W. Pine 24 S73°W 20 links</p>
---	--

B. Description of corner evidence found and/or method applies in restoring or re-establishing corner:

<p>9- Found concrete monument fitting Norman F. Parker's certificate of survey in section 10.</p>	<p>I-3 Set a standard DNR monument at the base of a old rotted wood post. This position fits well with measurements South and West on a working drawing believed to be George D. Henning's R.L.S. #2240</p>
---	---

C. Description of monument for corner and accessories established to perpetuate locating the position of the corner:

<p>9- Found concrete monument</p> <table border="0" style="width: 100%;"> <tr><td>Wit: 8" Maple</td><td>S33°E</td><td>33.68'</td></tr> <tr><td>4" Maple</td><td>South</td><td>41.09'</td></tr> <tr><td>4X4 Sign Post</td><td>N65°W</td><td>3.32'</td></tr> <tr><td>Centerline of M-72</td><td>North</td><td>45.5'</td></tr> <tr><td>Carsonite post</td><td>North</td><td>1'±</td></tr> </table>	Wit: 8" Maple	S33°E	33.68'	4" Maple	South	41.09'	4X4 Sign Post	N65°W	3.32'	Centerline of M-72	North	45.5'	Carsonite post	North	1'±	<p>I-3 Set DNR monument</p> <table border="0" style="width: 100%;"> <tr><td>Wit: 3" White Pine</td><td>N19°W</td><td>9.16'</td></tr> <tr><td>4" White Pine</td><td>N59°E</td><td>18.95'</td></tr> <tr><td>10" Oak</td><td>S58°E</td><td>17.22'</td></tr> <tr><td>9" Oak</td><td>S23°W</td><td>15.03'</td></tr> <tr><td>Carsonite Post</td><td>North</td><td>1'±</td></tr> <tr><td>Centerline of East-West trail road</td><td>South</td><td>65'±</td></tr> </table>	Wit: 3" White Pine	N19°W	9.16'	4" White Pine	N59°E	18.95'	10" Oak	S58°E	17.22'	9" Oak	S23°W	15.03'	Carsonite Post	North	1'±	Centerline of East-West trail road	South	65'±

Signed by:

Carl T. Kiiskila

Date:

4-8-02

Surveyor's Michigan License No.:

33981