

LAND CORNER RECORDATION CERTIFICATE

Filing Requirement of Act 74, Mich. PA 1970

For Corners In: Crawford Located In _____ Corner Code # _____
(County)

1. Public Land Survey		T	<u>26N</u>	R	<u>4W</u>	<u>D-4</u>
		T	_____	R	_____	_____
2. Property Controlling in Section	S	<u>8</u>	T	<u>26N</u>	R	<u>4W</u>
	S	_____	T	_____	R	_____
3. Miscellaneous Property in Section	S	_____	T	_____	R	_____
	S	_____	T	_____	R	_____


4. Lot No: _____ Recorded Plat: _____

5. Private Claims: _____

I, Carl T. Kiiskila, in a field survey on December 06, 2001 do hereby state that under requirements of PA 74, Michigan PA of 1970, the corner points mentioned in lines 1 and 2 above were in conformance with regulations and rules therefore as required in the current manual of survey instructions of the United States Department of the Interior, Bureau of Land Management or by a decree of a Court of Law and/or that the corner points mentioned in lines 3, 4 and 5 above were in conformance with the rules of the Michigan Board of Land Surveyors or by a Decree of a Court of Law; established, re-established, monumented, recovered, found as expressed below:

NOTE: Not more than 2 corners, all in the same town and range, may be recorded on this certificate.

Register of Deeds Stamp & File Number

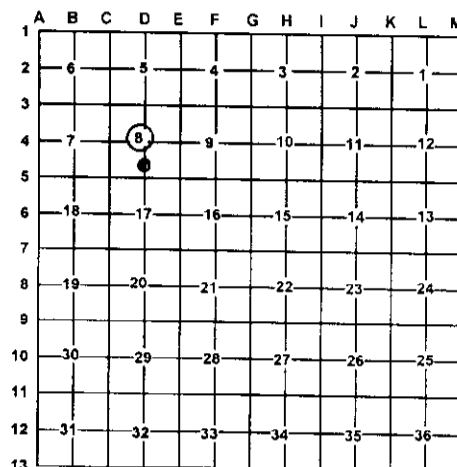

A. Description of original monument and accessories and/or subsequent restoration:

D-4 Kenneth J. Ostling RLS #10068. September 1960 Michigan Department of Conservation Land Corner Record shows a 1" X 24" pipe set at the intersections of the true 1/4 lines.

Wit: 10" B. Oak N25°E 19.9'
7" B. Oak S46°E 69.3'

12- Kenneth J. Ostling RLS #10068. September 1960 Michigan Department of Conservation Land Corner Record shows a 1" X 24" pipe set at the midpoint on line between the center and South 1/4 corner.

Wit: Notch in 22" W. Pine S60°E 7.9'
9" Spruce N12°E 21.0'

B. Description of corner evidence found and/or method applies in restoring or re-establishing corner:

D-4 Found a 1" pipe fitting Kenneth J. Ostling RLS #10068 survey in section 8.

12- Found a 1" pipe fitting Kenneth J. Ostling RLS #10068 survey in section 8.

C. Description of monument for corner and accessories established to perpetuate locating the position of the corner:

D-4 Found 1" pipe

Wit: Power Pole	South	2.65'
12" Oak	S70°E	13.93'
18" Oak	N44°E	20.55'
14" Oak	N75°W	60.21'
Carsonite Post	North	1'±

12- Found 1" pipe and added P.S. cap #33981

Wit: 4" Spruce	N23°W	6.10'
30" White Pine	S54°E	8.73'
34" White Pine	West	30.28'
6" Spruce	N55°E	37.23'
Carsonite Post	North	1'±

Signed by: _____

Carl T. Kiiskila

Date: _____

5-22-02

Surveyor's Michigan License No.: _____

33981