


# LAND CORNER RECORDATION CERTIFICATE


Filing Requirement of Act 74, Mich. PA 1970

For Corners In: Crawford (County)	Located In	Corner Code #	
1. Public Land Survey	T <u>26N</u> R <u>4W</u>	D-5	
	T <u>26N</u> R <u>4W</u>	M.C. E OF D-5	
2. Property Controlling in Section	S _____ T _____ R _____		
	S _____ T _____ R _____		
3. Miscellaneous Property in Section	S _____ T _____ R _____		
	S _____ T _____ R _____		
4. Lot No: _____	Recorded Plat: _____		
5. Private Claims: _____			

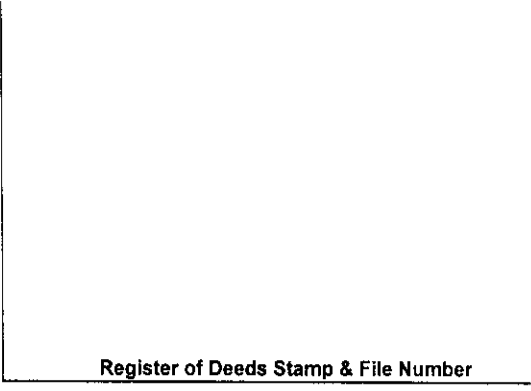

I, Carl T. Kiiskila, in a field survey on April 15, 2002 do hereby state that under requirements of PA 74, Michigan PA of 1970, the corner points mentioned in lines 1 and 2 above were in conformance with regulations and rules therefore as required in the current manual of survey instructions of the United States Department of the Interior, Bureau of Land Management or by a decree of a Court of Law and/or that the corner points mentioned in lines 3, 4 and 5 above were in conformance with the rules of the Michigan Board of Land Surveyors or by a Decree of a Court of Law, established, re-established, monumented, recovered, found as expressed below:

**NOTE: Not more than 2 corners, all in the same town and range, may be recorded on this certificate.**

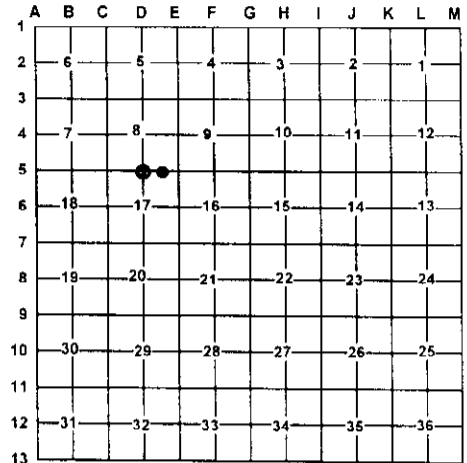

- A. Description of original monument and accessories and/or subsequent restoration:
- |   |   |
|---|---|
| D-5 G.L.O. Addison P. Brewer D.S. 1852.<br>set quarter section post.<br>Wit: Tamarack 5" N43°30'W 31 links<br>W. Birch 5" S54°30'E 21 links   | M.C. G.L.O. Addison P. Brewer D.S. 1852 intersected lake<br>and set meander post.<br>Wit: W. Pine 11" N44°W 12 links<br>W. Pine 8" S48°W 15 links   |
| Kenneth J. Ostling RLS #10068 September 1960 Michigan<br>Department of Conservation Land Corner Record shows set<br>a 1" pipe with 4" brass cap from an original stake point and<br>the remains of one original Tamarack bearing tree.<br>Wit: 7" Cedar N30°E 33 links<br>7" Cedar N44°W 52.5 links | Kenneth J. Ostling RLS #10068 September 1957 Michigan<br>Department of Conservation Land Corner Record shows set<br>a 1" pipe with 4" brass cap at old stake scribed M.P. on bank<br>of the lake 23 links West of the probable original meander<br>corner.<br>Wit: 18" R. Pine N22°W 48 links<br>18" R. Pine S48°W 66 links<br>8" Maple S18°W 10.5 links |

- B. Description of corner evidence found and/or method applies in restoring or re-establishing corner:
- |                                                                                    |   |
|------------------------------------------------------------------------------------|---|
| D-5 Found a 1" pipe with a brass cap fitting K.J. Ostling<br>survey and witnesses. | M.C.- Reset the witness corner for the meander corner from<br>K.J. Ostling survey in section 8 and two of the remaining<br>new bearing trees. |
|------------------------------------------------------------------------------------|---|

- C. Description of monument for corner and accessories established to perpetuate locating the position of the corner:
- |   |   |
|---|---|
| D-5 1" pipe with a brass cap.<br>Wit: 10" Cedar S83°E 7.71'<br>*9" Cedar N44°E 21.94'<br>*8" Cedar N37°W 34.93'<br>6" Cedar S75°W 24.41'<br>Carsonite Post North 1'±<br><br>* old witnesses by K.J. Ostling | M.C.- Set 1" X 48" pipe with a standard DNR aluminum<br>cap.<br>Wit: 16" Maple S74°W 51.29'<br>*20" Red Pine N23°W 32.98'<br>*20" Red Pine S20°W 43.44'<br>8" Maple N16°E 20.05'<br>Carsonite Post North 1'±<br><br>* old witnesses by K.J. Ostling |
|---|---|

Signed by: Carl T. Kiiskila Date: 5-22-02  
 Surveyor's Michigan License No.: 33981