

SURVEY & REMONUMENTATION

APR 07 1998

LAND CORNER RECORDATION CERTIFICATE
Filing Requirement of Act 74, Mich. P.A. 1970

For corners in SECTION

<u>Crawford</u> (County)	Located In:	Corner Code #
1. Public Land Survey	T 26N R 2W	<u>B-1</u> /
	T 27N R 2W	<u>B-13</u> /
	T _____ R _____	_____ /
	T _____ R _____	_____ /
2. Property Controlling In Section	S _____ T _____ R _____	_____ /
	S _____ T _____ R _____	_____ /
3. Miscellaneous Property in Sec.	S _____ T _____ R _____	_____ /
	S _____ T _____ R _____	_____ /
4. Lot No. _____, Recorded Plat _____		
5. Private Claims _____		

Handwritten initials

STATE OF MICHIGAN
CRAWFORD COUNTY
RECORDED

19 DEC 97 2:36 P.M.

SANDRA MOORE
REGISTER OF DEEDS

Register of Deeds Stamp & File Number

LIBER

3 PAGE 282

I, Marvin E. Myers, in a field survey on 27 MAY, 1997 do hereby state that under requirements of P.A. 74, Michigan P.A. of 1970, the corner points mentioned in lines 1 and 2 above were in conformance with regulations and rules therefore as required in the current manual of survey instructions of the United States Department of the Interior, Bureau of Land Management or by a decree of a Court of Law and /or that the corner points mentioned in lines 3, 4 and 5 above were in conformance with the rules of the Michigan Board of Land Surveyors or by a Decree of a Court of Law; established, re-established, monumented, recovered, found as expressed below:

	A	B	C	D	E	F	G	H	I	J	K	L	M
1													
2	6		5		4		3		2		1		
3													
4	7		8		9		10		11		12		
5													
6	18		17		16		15		14		13		
7													
8	19		20		21		22		23		24		
9													
10	30		29		28		27		26		25		
11													
12	31		32		33		34		35		36		
13													

NOTE: Not more than 2 corners, all in the same town and range, may be recorded on this certificate.

A. Description of original monument and accessories and/or subsequent restoration:

GLO 15 June 1852
Darwin A. Pettibone D.S.
Mon: Post
Wit: 6" Pine N57°W 10 links
6" Pine N46 ½ °E 16 links

Michigan Department of Conservation
Dean C. Delemater R.L.S.
Liber 5 Page 52, 15 June 1954
Mon: 1" Pipe with 4" Brass cap
Wit: 7" Cedar S83°W 25 links
7" Tamarack N10°E 52 links
(I believe this entry was miss indexed)


George D. Henning R.L.S.
Unrecorded Survey Sec.6 T26N R2W 1955
Mon: ½ " bar in corner 8" North of centerline of road
Wit: 14" Jack Pine S34 ½ °E 52.1'
8" Jack Pine S43°W 67.8'
5" Black Oak S22°E 51.8'

B. Description of corner evidence found and/or method applied in restoring or reestablishing corner:
Found Railroad spike 4' North of centerline. Accepted as the best available evidence of the position of the Original Government Corner. Replaced in exact location with Standard County monument in pavement monument box.

C. Description of monument for corner and accessories established to perpetuate locating the position of the corner:
Mon - Standard Crawford County Monument in pavement monument box 4' North of centerline of E-W road.
Wit: Set spike in West side 10" Jack Pine S15°E 66.29'
Set spike in West side 8" Jack Pine S49°E 103.75'
Set spike in Northeast side 8" Jack Pine N51°E 76.66'
Set spike in Northeast side 6" Jack Pine N35°W 41.95'

CRAWFORD COUNTY
PEER GROUP APPROVAL
DATE OCT 14, 1997

Marvin E. Myers
Marvin E. Myers, P.S.
County Surveyor

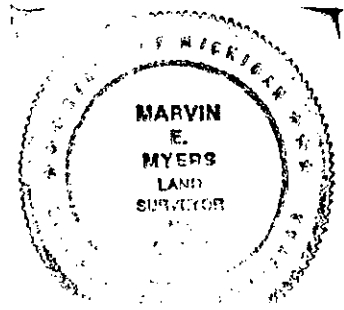

Signed by *Marvin E. Myers*
Surveyor's Michigan License No. 31600

Date DEC 15, 1997