

APR 07 1998

LAND CORNER RECORDATION CERTIFICATE
 Filing Requirement of Act 74, Mich. P.A. 1970

SECTION
 For corners in

Crawford Located In: Corner Code #
 (County)

1. Public Land Survey T 26NR 2W B-3
 T R
 T R
 T R

2. Property Controlling S T R
 In Section S T R

3. Miscellaneous S T R
 Property in Sec. S T R

4. Lot No. _____, Recorded Plat _____

5. Private Claims _____

STATE OF MICHIGAN
 CRAWFORD COUNTY
 RECORDED

19 DEC 97 2:37 P.M.

SANDRA MOORE
 REGISTER OF DEEDS

Register of Deeds Stamp & File Number

LIBER

3 PAGE 286

	A	B	C	D	E	F	G	H	I	J	K	L	M
1													
2	6	5	4	3	2	1							
3	•												
4	7	8	9	10	11	12							
5													
6	18	17	16	15	14	13							
7													
8	19	20	21	22	23	24							
9													
10	30	29	28	27	26	25							
11													
12	31	32	33	34	35	36							
13													

I, Marvin E. Myers, in a field survey on 27 MAY, 1997 do hereby state that under requirements of P.A. 74, Michigan P.A. of 1970, the corner points mentioned in lines 1 and 2 above were in conformance with regulations and rules therefore as required in the current manual of survey instructions of the United States Department of the Interior, Bureau of Land Management or by a decree of a Court of Law and /or that the corner points mentioned in lines 3, 4 and 5 above were in conformance with the rules of the Michigan Board of Land Surveyors or by a Decree of a Court of Law; established, re-established, monumented, recovered, found as expressed below:

NOTE: Not more than 2 corners, all in the same town and range, may be recorded on this certificate.

A. Description of original monument and accessories and/or subsequent restoration:

G.L.O.
 15 June 1852
 Darwin A. Pettibone D.S.
 Mon: Post
 Wit: 7" Pine N19°W 5 links
 12" Pine N65°E 31 links

George D. Henning R.L.S.
 Liber 1 Page 37, 1945
 Plat of Thendara
 Mon: 1" x 30" pipe
 Wit: 6" Spruce S86 1/2 °W 42.5'
 6" Balsam N45 1/2 °W 32.5'

George D. Henning R.L.S.
 Unrecorded Survey Sec.6 T26N R2W 1955
 Mon: Found 1" x 30" pipe
 Wit: 10" Jack Pine N60 1/2 °E 35.4'
 6" Spruce S86 1/2 °W 42.5'
 6" Balsam N45 1/2 °W 31.5'


B. Description of corner evidence found and/or method applied in restoring or reestablishing corner:
 Found 1" pipe in North South fence line; found 10" Jack Pine N60 1/2 °E 35.4'; found 6" Spruce S86 1/2 °W 42.5'; found 6" Balsam N45 1/2 °W 31.5' Accepted as the best available evidence of the position of the Original Corner. Replaced in exact location with Standard Crawford County Monument.

C. Description of monument for corner and accessories established to perpetuate locating the position of the corner:
 Mon - Standard Crawford County Monument

Wit: Set spike in East side 14" Poplar N8°E 10.40'
 Set spike in Southeast side 8" Oak with blaze N50°E 34.69'
 Set spike in North side 16" Jack Pine N87°E 32.00'
 Set spike in North side 32" White Pine S71°E 67.76'

CRAWFORD COUNTY
PEER GROUP APPROVAL
 DATE OCT 16, 1997

Marvin E. Myers
 Marvin E. Myers, P.S.
 County Surveyor

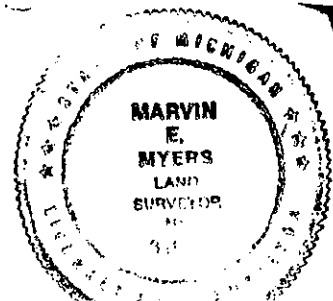

Signed by *Marvin E. Myers*
 Surveyor's Michigan License No. 31600

Date 28 15, 1997