

MAR 29 2000

SECTION

LAND CORNER RECORDATION CERTIFICATE
Filing Requirement of Act 74, Mich. P.A. 1970
Also Act 345, PA 1990

For corners in

Form with fields for Crawford (County), Located In, Corner Code #, and numbered sections 1-5 for Public Land Survey, Property Controlling, Miscellaneous, Lot No., and Private Claims.

STATE OF MICHIGAN
CRAWFORD COUNTY
RECORDED

28 DEC 99 3:01 P.M.

SANDRA BODRE
REGISTER OF DEEDS

Register of Deeds Stamp & File Number

LIBER 4 PAGE 69

I, James L. Schwandt, in a field survey on May 14, 1999, do hereby state that under requirements of P.A. 74, Michigan P.A. of 1970, the corner points mentioned in lines 1 and 2 above were in conformance with regulations and rules therefore as required in the current manual of survey instructions of the United States Department of the Interior, Bureau of Land Management or by a decree of a Court of Law and/or that the corner points mentioned in lines 3, 4 and 5 above were in conformance with the rules of the Michigan Board of Land Surveyors or by a Decree of a Court of Law; established, re-established, monumented, recovered, found as expressed below:

NOTE: Not more than 4 corners, all in the same town and range, may be recorded on this certificate.

A. Description of original monument and accessories and/or subsequent restoration:

- List of survey points including: 1.) Post set by James Mullet, D.S. in 1839; 2.) Carlos Laguire (date unknown); 3.) 1992, Fred King, #25852; 4.) 1994, Donald Marlatt; 5.) 1997, Fred King.


CRAWFORD COUNTY
PEER GROUP APPROVAL
DATE June 7, 1999
Marvin E. Myers, P.S.
County Surveyor

B. Description of corner evidence found and/or method applied in restoring or reestablishing corner:

- List of corner evidence: Found 1 1/2" pipe in concrete +/- 38' South of centerline road; Found nail in 9" J. Pine, S10°E, 18.75'; Found nail in 6" J. Pine, S62°E, 16.40'; Found nail in 9" J. Pine, N75°W, 22.25'.

C. Description of monument for corner and accessories established to perpetuate locating the position of the corner:

Replaced 1 1/2" pipe in concrete +/- 38' South of centerline road with Crawford County Monument and is accepted as a careful and faithful perpetuation of the position of the original corner.
Nail in 6" J. Pine, N10°E, 16.40'
Nail in 9" J. Pine, S62°E, 18.75'
Nail in 9" J. Pine, N75°W, 22.25'
Spike in 5" J. Pine, N2°W, 11.98'

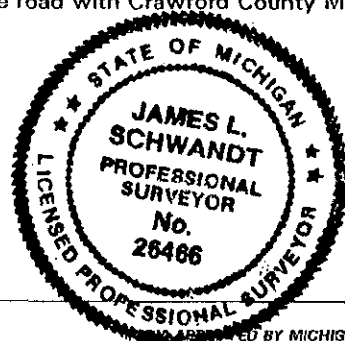

Signed by James L. Schwandt
Surveyor's Michigan License No. 26466

Date 12-10-99