


SURVEY & REMONUMENTATION

APR 07 1998

LAND CORNER RECORDATION CERTIFICATE
Filing Requirement of Act 74, Mich. P.A. 1970

For corners **SECTION**

<u>Crawford</u> (County)	Located in:	Corner Code #
1. Public Land Survey	T <u>27NR 1W</u> / <u>H-13</u>	<u>H-1</u>
	T <u>28N R 1W</u>	
	T _____ R _____	
	T _____ R _____	
2. Property Controlling in Section	S _____ T _____ R _____	
	S _____ T _____ R _____	
3. Miscellaneous Property In Sec.	S _____ T _____ R _____	
	S _____ T _____ R _____	

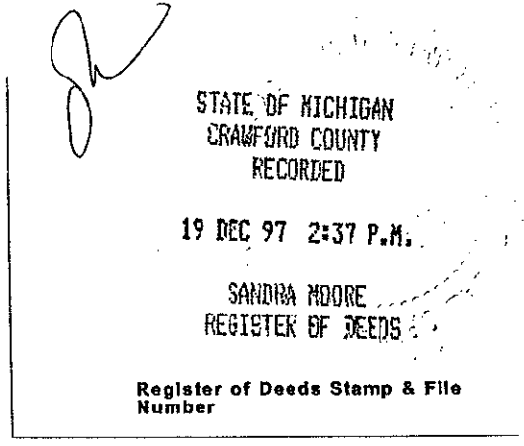

4. Lot No. _____, Recorded Plat **LIBER 3**

PAGE **289**

I, Marvin E. Myers, in a field survey on May 27, 1997 do hereby state that under requirements of P.A. 74, Michigan P.A. of 1970, the corner points mentioned in lines 1 and 2 above were in conformance with regulations and rules therefore as required in the current manual of survey instructions of the United States Department of the Interior, Bureau of Land Management or by a decree of a Court of Law and /or that the corner points mentioned in lines 3, 4 and 5 above were in conformance with the rules of the Michigan Board of Land Surveyors or by a Decree of a Court of Law; established, re-established, monumented, recovered, found as expressed below:

1					
2	6	5	4	3	2
3					1
4	7	8	9	10	11
5					12
6	18	17	16	15	14
7					13
8	19	20	21	22	23
9					24
10	30	29	28	27	26
11					25
12	31	32	33	34	35
13					36

NOTE: Not more than 2 corners, all in the same town and range, may be recorded on this certificate.

A. Description of original monument and accessories and/or subsequent restoration:

GLO - 1858 W. Warner, D.S.
Mon - 16" Y. Pine for Post
Wit: None given

Carlos LaGarica, AuSable State Forest

Mon - Found the 1/4 post which is a stump hole and rotting log 66 lks South of highway, An old Stump bearing the scribe "1/4" on the bench stands N75 1/2°E 52 and faces this point; found log and rotting hole for line tree to the East 10.31 chains, pro. Measure for 10.70. Set a 18" Monument: Checks well to the old Swamp line West.

Wit: Plts South 50 lks & North 10 lks,

1933 F. N. Smith for G.F. Delamater
Mon - Found Y. Pine Stump marked 1/4 badly burned doubt if this is corner.

L. 417, P. 606 F. King, P.S. Aug 13, 1996

Mon - Set 1/2" bar and cap single proportion

Wit: Nail & tag 6" W. Pine S47°E 50.66

Nail & tag SE side 12" J. Pine S62°W 47.84

Nail & tag SW side 14" W. Pine N57°W 11.32

Nail & tag W side 9" J. Pine N31°E 50.34

Oct 6, 1989 Don Marlatt, P.S.
Mon - Found 2" Pipe in concrete
Wit: 9" J. Pine N70°E 27.76
18" J. Pine S25°E 40.79
8" Poplar N33°W 5.19

B. Description of corner evidence found and/or method applied in restoring or reestablishing corner:

Found 1/2" bar & cap and accessories recorded in Liber 417, P. 606. **This position was not accepted.**
Found 2" Pipe concrete monument; found 9" J. Pine N70°E 27.76; 18" J. Pine S25°E 40.79; 8" Poplar N33°W 5.19
Replace 2" Pipe in exact location with a Standard Crawford County Monument.
Accepted this position as a perpetuation of the Original Government Corner.

C. Description of monument for corner and accessories established to perpetuate locating the position of the corner:
Mon - Standard Crawford County Monument.

Wit: Found spike in SW side 8" Aspen N33°W 5.19
Found spike in S. side 9" J. Pine N70°E 27.76
Found spike in W. side 18" J. Pine stump S25°E 40.79
Set nail & tag in W. side 8" Aspen S20°W 18.33
Set carsonite post 2' North
Set nail & tag in Southwest side 10" aspen S43°E 28.67

CRAWFORD COUNTY
PEER GROUP APPROVAL
DATE June 9, 1997

Marvin E. Myers
Marvin E. Myers, P.S.
County Surveyor

Signed by *Marvin E. Myers*
Surveyor's Michigan License No. 31600

Date *Dec 16, 1997*