

MAR 29 2000

SECTION

LAND CORNER RECORDATION CERTIFICATE
Filing Requirement of Act 74, Mich. P.A. 1970
Also Act 345, PA 1990

For corners in

Crawford (County)	Located In:	Corner Code #
1. Public Land Survey	T 28N R 1W	K-13
	T 27N R 1W	K-1
	T R	
	T R	
2. Property Controlling in Section	S T R	
	S T R	
3. Miscellaneous Property in Sec.	S T R	
	S T R	

STATE OF MICHIGAN
CRAWFORD COUNTY
RECORDED

28 DEC 99 3:01 P.M.

SANDRA MOORE
REGISTER OF DEEDS

Register of Deeds Stamp & File Number

4. Lot No. _____, Recorded Plat _____
5. Private Claims _____

LIBER 4 PAGE 67

I, James L. Schwandt, in a field survey on May 14, 19 99, do hereby state that under requirements of P.A. 74, Michigan P.A. of 1970, the corner points mentioned in lines 1 and 2 above were in conformance with regulations and rules therefore as required in the current manual of survey instructions of the United States Department of the Interior, Bureau of Land Management or by a decree of a Court of Law and/or that the corner points mentioned in lines 3, 4 and 5 above were in conformance with the rules of the Michigan Board of Land Surveyors or by a Decree of a Court of Law; established, re-established, monumented, recovered, found as expressed below:

NOTE: Not more than 4 corners, all in the same town and range, may be recorded on this certificate.

	A	B	C	D	E	F	G	H	I	J	K	L	M
1													
2	6			5		4		3		2		1	
3													
4	7			8		9		10		11		12	
5													
6	18			17		16		15		14		13	
7													
8	19			20		21		22		23		24	
9													
10	30			29		28		27		26		25	
11													
12	31			32		33		34		35		36	
13													

A. Description of original monument and accessories and/or subsequent restoration:

- 1.) Post set by James Mullett, D.S., 1839, 80 chains from SE corner of Township Pine 10", N25°E, 23 links
Remeasured in 1858 by W. Warner at 78.05 chains
- 2.) Carlos Laguire (date unknown)
Found corner and one witness stump

CRAWFORD COUNTY
PEER GROUP APPROVAL


DATE Jan 7, 1999
Marvin E. Myers
Marvin E. Myers, P.S.
County Surveyor

B. Description of corner evidence found and/or method applied in restoring or reestablishing corner:

- Found bent 1 1/2" pipe in concrete in centerline road and treeline to South and found 3/4" pipe 16.33' West of the 1 1/2" pipe.
- Found spike 16" R. Pine, N16°W, 86.08'
- Found spike 12" R. Pine, S41°W, 75.59'
- Found spike 12" R. Pine, N29°W, 33.46'
- Found spike 10" R. Pine, N20°E, 61.81'

C. Description of monument for corner and accessories established to perpetuate locating the position of the corner:

- Replaced 1 1/2" pipe in concrete in centerline road with Crawford County Monument and is accepted as a careful and faithful reestablishment of the position of the original corner.
- Spike 16" R. Pine, N16°W, 86.08'
- Spike 12" R. Pine, S41°W, 75.59'
- Spike 12" R. Pine, N29°W, 33.46'
- Spike 10" R. Pine, N20°E, 61.81'

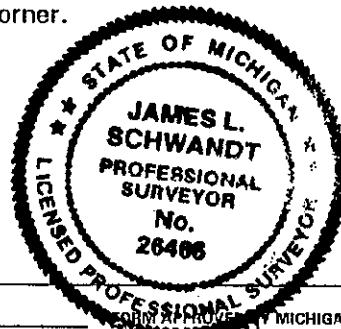

Signed by James L. Schwandt
Surveyor's Michigan License No. 26466

Date R-10-99