

STATE OF MICHIGAN
DEPARTMENT
OF
NATURAL RESOURCES

LAND CORNER RECORD

CRAWFORD COUNTY


T 27 N R 1 W

DESCRIPTION OF CORNER W 1/4 corner, Section 25

CORNER MONUMENT Set DNR Monument

DATE MONUMENT PLACED AND WITNESSED 8-31-72

WITNESSES TO CORNER.....

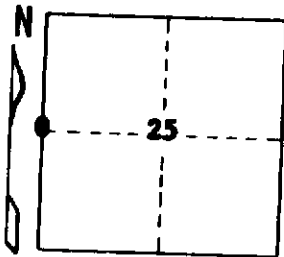

* 10" J. Pine N 34 W 28.6'

4" R. Pine S 22 W 37.5'


AND

* Old MBT

CIRCLE CORNER REGISTERED

DESCRIPTION IN DETAIL AS TO HOW CORNER WAS LOCATED AND IDENTIFIED OR RESTORED.

Found 1 1/2" pipe in Concrete block, as established in a previous survey by this Department. Apparently used in other surveys in this area.

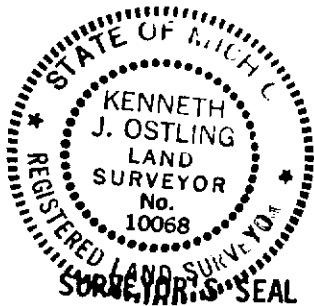

DISTRIBUTION:

Forestry Division, Lansing

SIGNED

Kenneth J. Ostling
REGISTERED LAND SURVEYOR

DATE

9-12-72

10068