

STATE OF MICHIGAN
DEPARTMENT
OF
NATURAL RESOURCES

LAND CORNER RECORD


CRAWFORD COUNTY
T 27 N R 1 W

DESCRIPTION OF CORNER N 1/16 on W Section line

CORNER MONUMENT Set 1 1/2" pipe with concrete block

DATE MONUMENT PLACED AND WITNESSED 9-5-72

WITNESSES TO CORNER.....

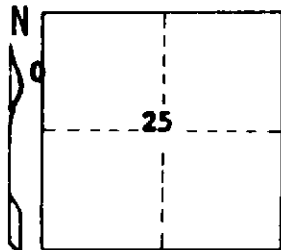

7" R. Pine N 42 E 49.1'


7" R. Pine S 68 E 65.8'

AND

CIRCLE CORNER REGISTERED

DESCRIPTION IN DETAIL AS TO HOW CORNER WAS LOCATED AND IDENTIFIED OR RESTORED.

Set by standard survey procedure for subdivision of sections.

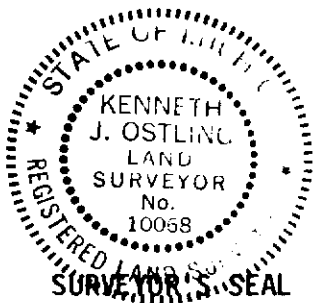

SIGNED

Kenneth J. Ostling
REGISTERED LAND SURVEYOR 10068

DATE 9-12-72

DISTRIBUTION:

Forestry Division, Lansing