

STATE OF MICHIGAN
DEPARTMENT
OF
NATURAL RESOURCES

LAND CORNER RECORD


CRAWFORD COUNTY
T 27 N R 1 W

DESCRIPTION OF CORNER N 1/4, Section 25

CORNER MONUMENT Set DNR monument

DATE MONUMENT PLACED AND WITNESSED 9-5-72

WITNESSES TO CORNER.....

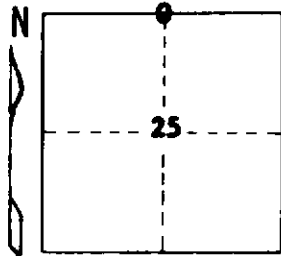

9" R. Pine S 38 W 23.3'


10" R. Pine S 08 E 19.8'

AND

CIRCLE CORNER REGISTERED

DESCRIPTION IN DETAIL AS TO HOW CORNER WAS LOCATED AND IDENTIFIED OR RESTORED.

Found 1 1/2" pipe as established in a previous survey by this Department. Originally established by proportionate measurement between section corners.

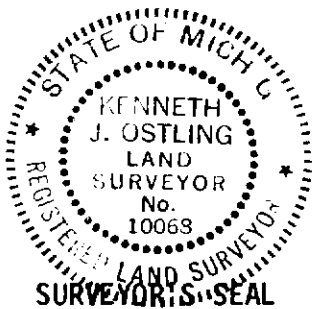

SIGNED

Kenneth J. Ostling
REGISTERED LAND SURVEYOR

DATE

9-12-72

10068

DISTRIBUTION:

Forestry Division, Lansing