

STATE OF MICHIGAN
DEPARTMENT
OF
NATURAL RESOURCES
LAND CORNER RECORD


CRAWFORD COUNTY
T 27 N R 1 W

DESCRIPTION OF CORNER SE Section corner

CORNER MONUMENT Set DNR Monument

DATE MONUMENT PLACED AND WITNESSED 8-28-72

WITNESSES TO CORNER..... 9" Poplar S 63 E 19.3'

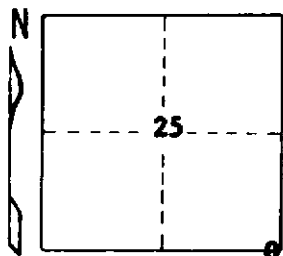

7" Maple S 29 E 66.0'


12" R. Pine S 53 W 84.1'

AND

CIRCLE CORNER REGISTERED

DESCRIPTION IN DETAIL AS TO HOW CORNER WAS LOCATED AND IDENTIFIED OR RESTORED.

Corner previously recovered by M. Schaaf from U.S.B.T. stump, still inplace.
Replaced with DNR Monument.

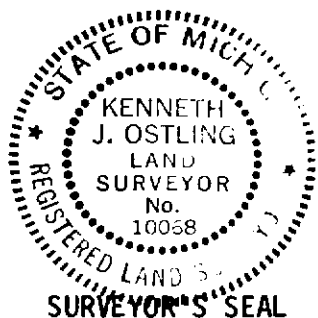

SIGNED Kenneth J. Ostling DATE 9-6-72
REGISTERED LAND SURVEYOR 10068

DISTRIBUTION:

Forestry Division, Lansing