

STATE OF MICHIGAN
DEPARTMENT
OF
NATURAL RESOURCES

LAND CORNER RECORD


CRAWFORD COUNTY
T 27 N R 1 W

DESCRIPTION OF CORNER NE Section Corner

CORNER MONUMENT Set DNR Monument

DATE MONUMENT PLACED AND WITNESSED 8-28-72

WITNESSES TO CORNER.....

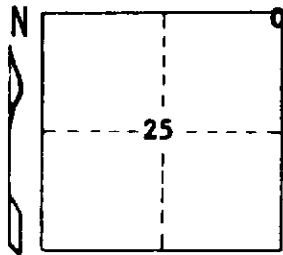

15" W. Pine N 09 W 39.8'


16" R. Pine N 74 W 39.35'

AND

CIRCLE CORNER REGISTERED

DESCRIPTION IN DETAIL AS TO HOW CORNER WAS LOCATED AND IDENTIFIED OR RESTORED.

Set corner on line and double distance from 1/4 and Section corner West, which conforms with LaGuire record. Falls in average intersection of firelines.

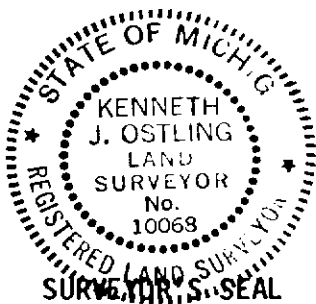

SIGNED Kenneth J. Ostling DATE 9-6-72
REGISTERED LAND SURVEYOR 10068

DISTRIBUTION:

Forestry Division, Lansing