

LAND CORNER RECORDATION CERTIFICATE

FILING REQUIREMENT OF ACT 74, MICH. P.A.1970

FOR CORNERS OF--:	LOCATED IN--:	CORNER CODE NUMBER
1. PUBLIC LAND SURVEY _____	T. <u>27</u> ^{N.} <u>1</u> ^{W.}	<u>A-8; C-7; C-8</u>
2. PROPERTY CONTROLLING IN SECTION _____	T. _____ ^{N.} ^{S.} R. _____ ^{E.} ^{W.}	_____
3. MISCELLANEOUS PROPERTY IN SECTION _____	T. _____ ^{N.} ^{S.} R. _____ ^{E.} ^{W.}	_____
4. LOT NO. _____, RECORDED PLAT _____		
5. PRIVATE CLAIMS _____		

REGISTER OF DEEDS STAMP AND FILING NUMBER

I, Kenneth J. Ostling, do hereby certify that under requirements of P.A. 74, Michigan P.A. of 1970, the corner points mentioned in lines 1 and 2 above were, in a field survey on May 27, 1975, established, re-established, monumented, re-monumented, recovered or restored as expressed below and in conformance with regulations and rules therefore as required in the current manual of survey instructions of the United States Department of the Interior, Bureau of Land Management or by a decree of a court of law. Furthermore, that the corner points mentioned in lines 3, 4 and 5 above were, in a field survey on _____, 19____, found, recovered, restored, established or re-established as expressed below and in conformance with the rules of the Michigan State Board of Registration for Land Surveyors or, by a Decree of a Court of law:

A. Description of original monument and accessories and/or subsequent restoration:


B. Description of corner evidence found and/or method applied in restoring or re-establishing corner:

- A-8 Found corner as previously established by M. Schaaf 1935 survey.
- C-7 Found corner as previously established in 1935 survey by M. Schaaf.
- C-8 Set by proportionate measurement between section corners. Schaaf corner apparently removed in construction.

C. Description of monument for corner and accessories established to perpetuate locating the position of the corner:

A-8	C-7	C-8
Set DNR monument red-top post 10'E	1½" Pipe in Concrete 8" R. Pine S40°W 53.8	Set DNR Monument 7" R. Pine N53°E 22.5
8" W. Oak N50°W 27.25	7" R. Pine S45°E 36.7	5" R. Pine S30°E 24.5
8" R. Oak S55°W 16.5	Cedar Post NE 20'	Cedar Post East 14'

SIGNED BY *Kenneth J. Ostling* DATE _____
 SURVEYOR'S MICHIGAN REGISTRATION NO. 10068

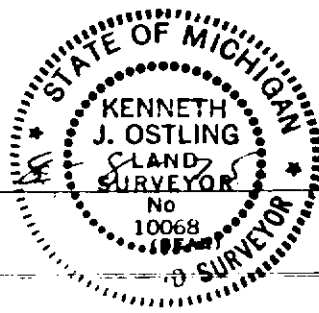

FOR STATE AND UNITED STATES AGENCIES:
 SIGNED BY _____ DATE _____
CHIEF OF SURVEY PARTY
 APPROVED AND SIGNED BY _____ DATE _____
MICHIGAN REGISTERED LAND SURVEYOR

SURVEYOR'S MICHIGAN REGISTRATION NO. _____