

LAND CORNER RECORDATION CERTIFICATE

FILING REQUIREMENT OF ACT 74, MICH. P.A.1970

| FOR CORNERS OF --: | LOCATED IN --: | CORNER CODE NUMBER |
|--|---|-----------------------|
| 1. PUBLIC LAND SURVEY _____ | T. 27 ^{N.} <input checked="" type="radio"/> R. 1 ^{W.} <input checked="" type="radio"/> | D-11; E-7; E-10; G-10 |
| 2. PROPERTY CONTROLLING IN SECTION _____ | T. _____ ^{N.} <input type="radio"/> ^{S.} <input type="radio"/> R. _____ ^{E.} <input type="radio"/> ^{W.} <input type="radio"/> | _____ |
| 3. MISCELLANEOUS PROPERTY IN SECTION _____ | T. _____ ^{N.} <input type="radio"/> ^{S.} <input type="radio"/> R. _____ ^{E.} <input type="radio"/> ^{W.} <input type="radio"/> | _____ |
| 4. LOT NO. _____, RECORDED PLAT _____ | | |
| 5. PRIVATE CLAIMS _____ | | |

REGISTER OF DEEDS STAMP AND FILING NUMBER

I, Kenneth J. Ostling do hereby certify that under requirements of P.A. 74, Michigan P.A. of 1970, the corner points mentioned in lines 1 and 2 above (identified with circles on index code diagram - over) were, in a field survey on November 22, 1974, established, re-established, monumented, re-monumented, recovered or restored as expressed below and in conformance with regulations and rules therefore as required in the current manual of survey instructions of the United States Department of the Interior, Bureau of Land Management or by a decree of a court of law. Furthermore, that the corner points mentioned in lines 3, 4 and 5 above were, in a field survey on _____ 19____, found, recovered, restored, established or re-established as expressed below and in conformance with the rules of the Michigan State Board of Registration for Land Surveyors or, by a Decree of a Court of law:

A. Description of original monument and accessories and/or subsequent restoration:

B. Description of corner evidence found and/or method applied in restoring or re-establishing corner:


- D-11 Restored Schaaf corner to M.P.O.L. as located in 1934 survey.
- E-7 Found Schaaf corner as restored in 1934 survey from U.S.B.T.'s.
- E-10 Found corner as previously restored by Marcus Schaaf in 1934 survey.
- G-10 Reset Schaaf corner at midpoint on line between section corners.

C. Description of monument for corner and accessories established to perpetuate locating the position of the corner:

| D-11 | E-7 | E-10 |
|---|--|--|
| 1½" pipe in conc. red-top post 8' N. | 1½" pipe in block of conc. red-top post 10' NW | 1½" pipe in block of conc. red-top post 24' W. |
| 18" R. Pine N50°E 46.1 | 7" R. Pine S55°W 55.3 | 7" J. Pine S56°E 55.85 |
| 18" R. Pine S14°E 75.55 | 6" R. Pine S26°E 41.2 | 5" J. Pine S31°W 51.7 |
| G-10 | | |
| 1½" pipe in block of conc. red-top post 5' E. | | |
| 7" J. Pine N82°W 62.0 | | |
| 8" J. Pine S10°E 52.2 | | |

SIGNED BY *Kenneth J. Ostling* SURVEYOR'S MICHIGAN REGISTRATION NO. 10028

DATE 12-30-74

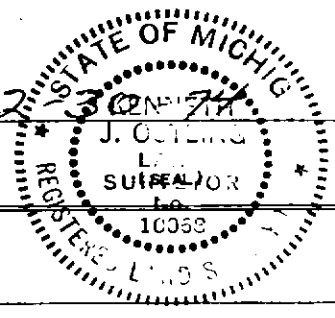

FOR STATE AND UNITED STATES AGENCIES:

SIGNED BY _____ DATE _____
CHIEF OF SURVEY PARTY

APPROVED AND SIGNED BY _____ DATE _____
MICHIGAN REGISTERED LAND SURVEYOR

(SEAL)

SURVEYOR'S MICHIGAN REGISTRATION NO. _____ CRAWFORD COUNTY