

LAND CORNER RECORDATION CERTIFICATE

FILING REQUIREMENT OF ACT 74, MICH. P.A.1970

FOR CORNERS OF --:	LOCATED IN --:	CORNER CODE NUMBER
1. PUBLIC LAND SURVEY _____	T. <u>27</u> N. R. <u>1</u> W.	M-5; M-6; M-7
2. PROPERTY CONTROLLING IN SECTION <u>13</u>	T. <u>27</u> N. R. <u>1</u> W.	14
3. MISCELLANEOUS PROPERTY IN SECTION _____	T. _____ N. S. R. _____ E. W.	
4. LOT NO. _____, RECORDED PLAT _____		
5. PRIVATE CLAIMS _____		

REGISTER OF DEEDS STAMP AND FILING NUMBER

I, Kenneth J. Ostling, do hereby certify that under requirements of P.A. 74, Michigan P.A. of 1970, the corner points mentioned in lines 1 and 2 above were, in a field survey on June 28, 1979, 19____, established, re-established, monumented, re-monumented, recovered or restored as expressed below and in conformance with regulations and rules therefore as required in the current manual of survey instructions of the United States Department of the Interior, Bureau of Land Management or by a decree of a court of law. Furthermore, that the corner points mentioned in lines 3, 4 and 5 above were, in a field survey on _____, 19____, found, recovered, restored, established or re-established as expressed below and in conformance with the rules of the Michigan State Board of Registration for Land Surveyors or, by a Decree of a Court of law:

~~A. Description of original monument and accessories and/or subsequent restoration:~~

C. (continued)

	14		
Set 5/8" Rod w/RLS Cap			
3" R. Pine	N11 ⁰ W	23.40	
4" Maple	S33 ⁰ W	37.23	


B. Description of corner evidence found and/or method applied in restoring or re-establishing corner:

- M-5 Found 1½" pipe in place, probably as established in M. Schaaf survey of the County line (1930's).
- M-6 Set corner by proportionate measurement, midpoint on line between section corners. Unable to locate previous corner.
- M-7 Found 1½" pipe w/concrete base as established in 1930's survey by M. Schaaf. In line road west.
- 14 Set corner by standard survey procedure for the subdivision of sections.

C. Description of monument for corner and accessories established to perpetuate locating the position of the corner:

M-5	M-6	M-7
Found 1½" Pipe	Set DNR Monument	Set DNR Monument
11" Oak N67 ⁰ W 49.68	8" R. Pine S40 ⁰ W 54.10	12" Oak N65 ⁰ W 38.80
8" J. Pine N22 ⁰ W 20.52	8" J. Pine S30 ⁰ E 20.78	3" Maple S50 ⁰ W 50.35
	Cedar Post East 11'	Cedar Post East 15'

SIGNED BY Kenneth J. Ostling
 SURVEYOR'S MICHIGAN REGISTRATION NO. 10068

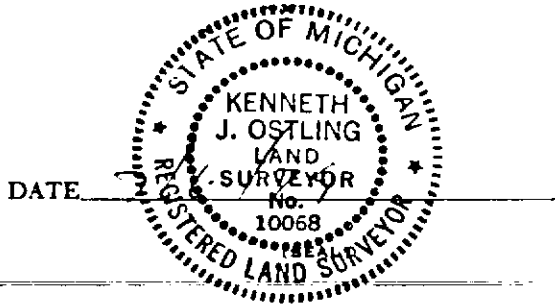

FOR STATE AND UNITED STATES AGENCIES:

SIGNED BY _____ DATE _____
CHIEF OF SURVEY PARTY

APPROVED AND SIGNED BY _____ DATE _____
MICHIGAN REGISTERED LAND SURVEYOR

SURVEYOR'S MICHIGAN REGISTRATION NO. _____ CRAWFORD COUNTY

MAY PLACE SKETCH ON BACK OR ATTACHED SHEET