

LAND CORNER RECORDATION CERTIFICATE

FILING REQUIREMENT OF ACT 74, MICH. P.A.1970

FOR CORNERS OF--	LOCATED IN--	CORNER CODE NUMBER
1. PUBLIC LAND SURVEY	T. 27 N. R. 1 W.	K-6; L-6
2. PROPERTY CONTROLLING IN SECTION 13	T. 27 N. R. 1 W.	10
3. MISCELLANEOUS PROPERTY IN SECTION	T. S. R. E. W.	
4. LOT NO. _____, RECORDED PLAT _____		
5. PRIVATE CLAIMS _____		

REGISTER OF DEEDS STAMP AND FILING NUMBER

I, Kenneth J. Ostling, do hereby certify that under requirements of P.A. 74, Michigan P.A. of 1970, the corner points mentioned in lines 1 and 2 above were, in a field survey on June 19, 1979, established, re-established, monumented, re-monumented, recovered or restored as expressed below and in conformance with regulations and rules therefore as required in the current manual of survey instructions of the United States Department of the Interior, Bureau of Land Management or by a decree of a court of law. Furthermore, that the corner points mentioned in lines 3, 4 and 5 above were, in a field survey on _____, 19____, found, recovered, restored, established or re-established as expressed below and in conformance with the rules of the Michigan State Board of Registration for Land Surveyors or, by a Decree of a Court of law:

A. Description of original monument and accessories and/or subsequent restoration:


B. Description of corner evidence found and/or method applied in restoring or re-establishing corner:

- K-6 Found 2" pipe at fence corner, apparently used in previous surveys in this area.
- L-6 Set corner at the calculated intersection of the true ¼ lines, per standard procedure for the subdivision of sections.
- 10 Set corner by standard survey procedure for the subdivision of sections.

C. Description of monument for corner and accessories established to perpetuate locating the position of the corner:

K-6	L-6	10
Set DNR Mon. & Cedar Post	Set 5/8" Rod w/RLS Cap & Cedar Post	Set 5/8" Rod w/RLS Cap & Cedar Post
6" Balsam S31°W 47.78	4" W. Oak S01°W 6.11	24" Oak S74°E 19.40
6" Balsam S73°E 33.85	7" Maple N53°E 9.55	6" Oak S14°W 16.42
	3" Conc. Mon. S21°E 10.31	

SIGNED BY *Kenneth Ostling* DATE _____
 SURVEYOR'S MICHIGAN REGISTRATION NO. 10068

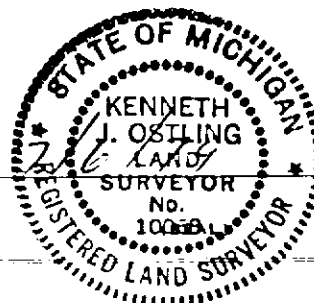

FOR STATE AND UNITED STATES AGENCIES:

SIGNED BY _____ DATE _____
CHIEF OF SURVEY PARTY
 APPROVED AND SIGNED BY _____ DATE _____
MICHIGAN REGISTERED LAND SURVEYOR

SURVEYOR'S MICHIGAN REGISTRATION NO. _____ CRAWFORD COUNTY