

# LAND CORNER RECORDATION CERTIFICATE

FILING REQUIREMENT OF ACT 74, MICH. P.A.1970

FOR CORNERS OF--:	LOCATED IN--:	CORNER CODE NUMBER
1. PUBLIC LAND SURVEY..... T. _____	N. _____ S., R. _____ E. W.	_____
2. PROPERTY CONTROLLING IN SECTION 15 , T. 27	N. _____ S., R. 1 W. ●	5; 6; 9; 10
3. MISCELLANEOUS PROPERTY IN SECTION _____ , T. _____	N. _____ S., R. _____ E. W.	_____
4. LOT NO. _____ , RECORDED PLAT _____		
5. PRIVATE CLAIMS _____		

REGISTER OF DEEDS STAMP AND  
FILING NUMBER

I, Kenneth J. Ostling, do hereby certify that under requirements of P.A. 74, Michigan P.A. of 1970, the corner points mentioned in lines 1 and 2 above were, in a field survey on September 19, 1978, established, re-established, monumented, re-monumented, recovered or restored as expressed below and in conformance with regulations and rules therefore as required in the current manual of survey instructions of the United States Department of the Interior, Bureau of Land Management or by a decree of a court of law. Furthermore, that the corner points mentioned in lines 3, 4 and 5 above were, in a field survey on \_\_\_\_\_, 19\_\_\_\_, found, recovered, restored, established or re-established as expressed below and in conformance with the rules of the Michigan State Board of Registration for Land Surveyors or, by a Decree of a Court of law:

~~A. - Description of original monument and accessories and/or subsequent restoration.~~

C. (continued)

- 10
- Left concrete mon. in place
- set cedar post
- 6" Oak S04°E 31.21
- 8" R. Pine S88°E 58.53
- Old wit. pine stump
- S78°W 37.77

B. Description of corner evidence found and/or method applied in restoring or re-establishing corner:


- 5 Set corner by standard survey procedure for the subdivision of sections.
- 6 Set corner by standard survey procedure for the subdivision of sections.
- 9 Set corner by standard survey procedure for the subdivision of sections.
- 10 Found corner in place from previous survey, possibly G. F. DeLaMater. Found and used in 1972 Henning survey.

C. Description of monument for corner and accessories established to perpetuate locating the position of the corner:

- |                             |                                       |  |
|-----------------------------|---------------------------------------|--|
| 5                           | 6                                     | 9  |
| Set 5/8" rod and cedar post | Set 5/8" rod w/RLS cap and cedar post | Set 5/8" iron bar w/RLS cap and cedar post |
| 10" J. Pine S83°W 23.0      | 12" Oak S57°W 19.68                   | 12" J. Pine S23°W 10.72                    |
| 10" J. Pine N24°W 41.25     | 5" J. Pine S16°W 17.97                | 8" J. Pine N48°W 7.85                      |

SIGNED BY *Kenneth Ostling*  
 SURVEYOR'S MICHIGAN REGISTRATION NO. 10068

DATE 11-13-78

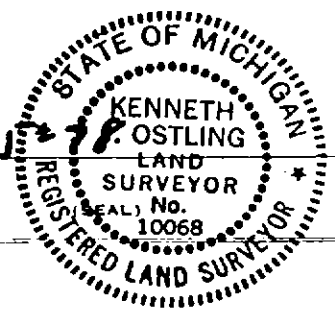

FOR STATE AND UNITED STATES AGENCIES:

SIGNED BY \_\_\_\_\_ DATE \_\_\_\_\_  
CHIEF OF SURVEY PARTY

APPROVED AND SIGNED BY \_\_\_\_\_ DATE \_\_\_\_\_  
MICHIGAN REGISTERED LAND SURVEYOR

SURVEYOR'S MICHIGAN REGISTRATION NO. \_\_\_\_\_ CRAWFORD COUNTY

MAY PLACE SKETCH ON BACK OR ATTACHED SHEET