

LAND CORNER RECORDATION CERTIFICATE

FILING REQUIREMENT OF ACT 74, MICH. P.A.1970

FOR CORNERS OF --:	LOCATED IN --:	CORNER CODE NUMBER
1. PUBLIC LAND SURVEY _____	T. 27 N. R. 1 W. ●	G-7; H-7; I-7
2. PROPERTY CONTROLLING IN SECTION 15 _____	T. 27 N. R. 1 W. ●	13
3. MISCELLANEOUS PROPERTY IN SECTION _____	T. _____ N. S. R. _____ E. W.	
4. LOT NO. _____, RECORDED PLAT _____		
5. PRIVATE CLAIMS _____		

REGISTER OF DEEDS STAMP AND FILING NUMBER

I, Kenneth J. Ostling, do hereby certify that under requirements of P.A. 74, Michigan P.A. of 1970, the corner points mentioned in lines 1 and 2 above were, in a field survey on September 19, 1978, established, re-established, monumented, re-monumented, recovered or restored as expressed below and in conformance with regulations and rules therefore as required in the current manual of survey instructions of the United States Department of the Interior, Bureau of Land Management or by a decree of a court of law. Furthermore, that the corner points mentioned in lines 3, 4 and 5 above were, in a field survey on _____, 19____, found, recovered, restored, established or re-established as expressed below and in conformance with the rules of the Michigan State Board of Registration for Land Surveyors or, by a Decree of a Court of law:

A-- Description of original monument and accessories and/or subsequent restoration:
 C. (continued)

13
Left ½" bar w/RLS cap in place
Set cedar post
6" Oak S31°E 69.25
8" R. Pine S89°W 120.8

B. Description of corner evidence found and/or method applied in restoring or re-establishing corner:

G-7 Found ½" pipe at corner, probably as established by G. F. DeLaMater and used in surveys by Ostling Surveys, Inc., and G. D. Henning.

H-7 Found ½" iron bar in remains of pine stump as established in previous survey by G. D. Henning. Apparently used in subdivision of Section 15. Schaaf pipe removed.


I-7 Found 1¼" pipe/concrete monument at corner as established in 1940's survey by Marcus Schaaf. Apparently used in other local surveys.

13 Left corner in place as established in G. D. Henning survey.

C. Description of monument for corner and accessories established to perpetuate locating the position of the corner:

G-7 Replaced ½" pipe w/DNR Mon. 14" Oak S44°W 41.85 20" R. Pine S09°E 57.7 Set cedar guar post	H-7 Left ½" rerod w/RLS cap (2240) in place. Nail & ref. cap in 20" R.Pine South 70.41 Nail & ref. cap in 10" R.Pine S80°W 32.65	I-7 Set DNR mon. in place of 1¼" pipe 4" R. Pine S26°W 29.35 5" Oak N75°E 13.8
---	---	---

SIGNED BY Kenneth J. Ostling
 SURVEYOR'S MICHIGAN REGISTRATION NO. 10068

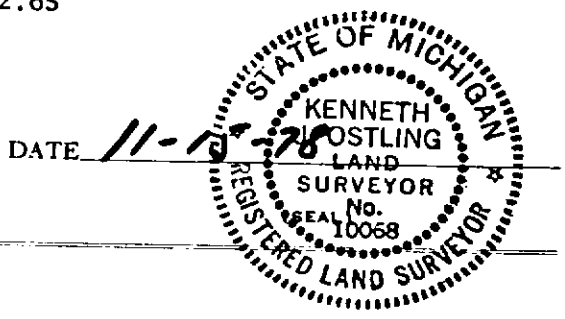

FOR STATE AND UNITED STATES AGENCIES:
 SIGNED BY _____ DATE _____
CHIEF OF SURVEY PARTY
 APPROVED AND SIGNED BY _____ DATE _____
MICHIGAN REGISTERED LAND SURVEYOR

SURVEYOR'S MICHIGAN REGISTRATION NO. _____ CRAWFORD COUNTY