

# LAND CORNER RECORDATION CERTIFICATE

## FILING REQUIREMENT OF ACT 74, MICH. P.A. 1970

FOR CORNERS OF --:	LOCATED IN --:	CORNER CODE NUMBER
1. PUBLIC LAND SURVEY	T 27 N R 1 W	H-3
2. PROPERTY CONTROLLING IN SECTION 10	T 27 N R 1 W	1; 11; 12; 15
3. MISCELLANEOUS PROPERTY IN SECTION	T N R W	
4. LOT NO. ---, RECORDED PLAT		
5. PRIVATE CLAIMS		

REGISTER OF DEEDS STAMP AND FILING NUMBER

I, Kenneth J. Ostling, do hereby certify that under requirements of P.A. 74, Michigan P.A. of 1970 the corner points mentioned in lines 1 and 2 above were, in a field survey on October 25, 1979 established, re-established, monumented, re-monumented, recovered or restored as expressed below and in conformance with regulations and rules therefore as required in the current manual of survey instructions of the United States Department of the Interior, Bureau of Land Management or by a decree of a court of law. Furthermore, that the corner points mentioned in lines 3, 4 and 5 above were, in a field survey on 1979 found, recovered, restored, established or re-established as expressed below and in conformance with the rules of the Michigan State Board of Registration for Land Surveyors or, by a Decree of a Court of law:

~~A. Description of original monument and accessories and re-established~~  
**C. (continued)**

12	15
Set 5/8" Rod w/RLS Cap and Cedar Post	Set 5/8" Rod
12" J. Pine N33°E 43.35	8" J. Pine N60°E 23.71
5" Oak N80°W 49.10	8" J. Pine N46°W 12.92

B. Description of corner evidence found and or method applied in restoring or re-establishing corner.

-3 Fd. 1½" pipe as established in 1930's survey under supervision of Marcus Schaaf. Claimed to have remnants of U.S. evidence.

1 Set by standard survey procedure for the subdivision of sections.

11 Set by standard survey procedure for the subdivision of sections.

12 Set by standard survey procedure for the subdivision of sections.


15 Set by standard survey procedure for the subdivision of sections.

C. Description of monument for corner and accessories established to perpetuate locating the position of the corner

H-3	I	11
Fd. 1½" pipe in conc. set DNR Monument	Set 5/8" rod w/RLS Cap & Cedar Post	Set 5/8" Rod w/RLS Cap and Red-Top Post
3" Spruce N20°E 24.38	7" J. Pine S25°E 5.95	3" J. Pine S72°W 8.25
6" Cedar N75°W 38.00	7" J. Pine S45°W 14.15	5" J. Pine S72°E 14.8

SIGNED BY Kenneth J. Ostling  
 SURVEYOR'S MICHIGAN REGISTRATION NO. 10068  
 FOR STATE AND UNITED STATES AGENCIES

DATE 11/1/79

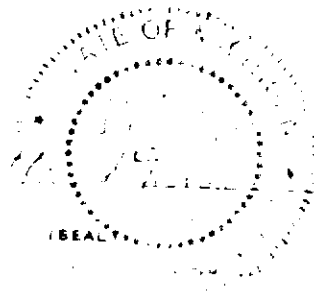

SIGNED BY \_\_\_\_\_  
 APPROVED AND SIGNED BY \_\_\_\_\_  
CHIEF OF SURVEY PARTY  
MICHIGAN REGISTERED LAND SURVEYOR

DATE \_\_\_\_\_

DATE \_\_\_\_\_

(SEAL)

SURVEYOR'S MICHIGAN REGISTRATION NO. \_\_\_\_\_

