

LAND CORNER RECORDATION CERTIFICATE
Filing Requirement of Act 74, Mich. P.A. 1970

STATE OF MICHIGAN
COUNTY OF CRAWFORD

FILED FOR RECORD THIS
16th DAY OF June, 1990 AT
9:30 am/pm, IN LIBER 2
PAGE 337.
E. R. Wick
Register of Deeds

or corners in
Crawford (County) Located In: Corner Code //
Public Land Survey T 27NR 1W C-13
T R
T R
T R
Property Controlling S T R
in Section S T R
Miscellaneous S T R
Property in Sec. S T R

Register of Deeds Stamp & File Number

Lot No. Recorded Plat
Private Claims

	A	B	C	D	E	F	G	H	I	J	K	L	M
2	6	5	4	3	2	1							
3													
4	7	8	9	10	11	12							
5													
6	18	17	16	15	14	13							
7													
8	19	20	21	22	23	24							
9													
10	30	29	28	27	26	25							
11													
12	31	32	33	34	35	36							
13													

Norman C. Caldwell March 19 90
in a field survey on

I hereby certify that under requirements of P.A. 74, Michigan P.A. of 1970, the corner points mentioned in lines 1 and 2 above were in conformance with regulations and rules therefore as required in the current manual of survey instructions of the United States Department of the Interior, Bureau of Land Management or by a decree of a Court of Law and/or that the corner points mentioned in lines 3, 4 and 5 above were in conformance with the rules of the Michigan Board of Land Surveyors or by a Decree of a Court of Law; established, re-established, monumented, re-monumented, recovered, found as expressed below:

NOTE: Not more than 4 corners, all in the same town and range, may be recorded on this certificate.

Description of original monument and accessories and/or subsequent restoration:


- (C-13) Original post set by Mullett in 1839.
Pine 8" N66 1/2°W 1.50 (99.00')
Pine 8" N45°E .28 (18.48')
Replaced by Pettibone, June 12, 1852.
Y. Pine 8" S45°E .38 (25.08')
Pine 7" S70°W 1.57 (103.62')
Replaced by Pettibone, July 27, 1852
Spruce Pine 7" N20°E .45 (29.70')
Y. Pine 10" N81°W 1.42 (93.72')

Description of corner evidence found and/or method applied in restoring or reestablishing corner:

- (C-13) 2" pipe in conc. block placed by Schaaf, 1934, from SE orig. BT.
Fnd. by Gerschbacher, LS 18990, April 3, 1989.
S63°W 75.1' 20" R. Pine
N35°W 72.23' 8" R. Pine
S67°E 80.90' 10" J. Pine
rec. in L 2, pg 319

Description of monument for corner and accessories established to perpetuate locating the position of the corner:

- (C-13) Standard Cor. 31&32, T27N-R1W
Fnd. 1 3/4" iron pipe in conc. And is accepted as a careful & faithful perpetuation of the position of the original corner.
South 20' Carsonite Witness Post
N31°W 72.23' 8" R. Pine (R)
S60°E 80.9' 10" J. Pine (R)
S24°W 72.3' 7" J. Pine
S70°W 75.1' 20" R. Pine (R)

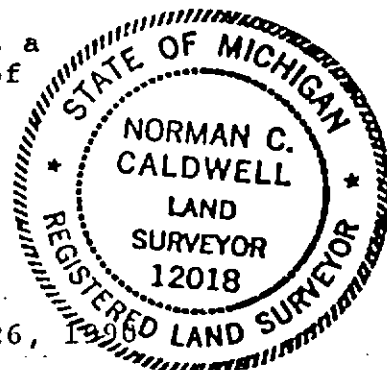

signed by Norman C. Caldwell

Date April 26, 1990