LIBER 2 PAGE 340

STATE OF MICHIGAN
COUNTY OF CRAWFORD
FILED FOR RECORD THIS
6th DAY OF June, 1990 AT
9:30 (am)/pm, IN LIBER 2
PAGE 340.
Elizabeth A. Wieland
Register of Deeds

Register of Deeds Stamp & File Number

LAND CORNER RECORDATION CERTIFICATE

Filing Requirement of Act 74, Mich. P.A. 1970

or corners in

Crawford (County) Located In: Corner Code //

Public Land Survey		T 27N	R 1W	E-8
		T	R	
		T	R	
		T	R	
Property Controlling	S	T	R	
in Section	S	T	R	
Miscellaneous	S	T	R	
Property in Sec.	S	T	R	

Lot No. , Recorded Plat
Private Claims

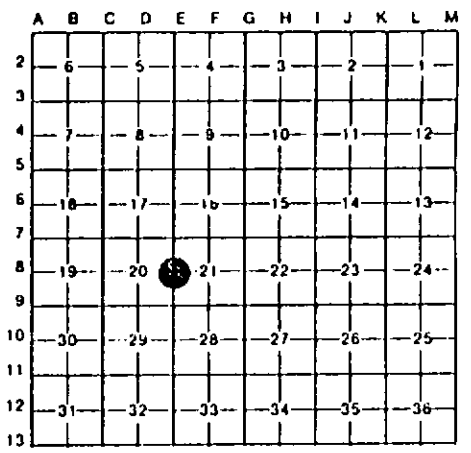

Norman C. Caldwell, in a field survey on March, 19 90,
o hereby certify that under requirements of P.A. 74, Michigan P.A. of 1970, the corner points mentioned . lines 1 and 2 above were in conformance with regulations and rules therefore as required in the urrent manual of survey instructions of the United States Department of the Interior, Bureau of Land anagement or by a decree of a Court of Law and/or that the corner points mentioned in lines 3, 4 and 5 bove were in conformance with the rules of the Michigan Board of Land Surveyors or by a Decree of a ourt of Law, established, re-established, monumented, re-monumented, recovered, found as xpressed below.

OTE: Not more than 4 corners, all in the same town and range, may be recorded on this certificate.

Description of original monument and accessories and/or subsequent restoration:

(E-8) Post set by Pettibone, July 25, 1852.
Spruce Pine 13" N72°E .17 (11.22')
Y. Pine 18" S73°W .69 (45.54')

Description of corner evidence found and/or method applied in restoring or reestablishing corner:

(E-8) LaGuire fnd. base of orig. government post, placed pipe & conc. block, 1934.
K.J. Ostling, LS 10068, placed DNR pipe & cap at this position, May 27, 1975.
S55°E 57.3' 8" J. Pine
N43°E 89.1' 10" J. Pine
rec. in L 2, pg 28

Description of monument for corner and accessories established to perpetuate locating the position of the corner:

(E-8) 1/4 cor. 20&21, T27N-R1W
Fnd. DNR pipe & cap. And is accepted as a careful & faithful perpetuation of the position of the orig. corner.
West 5' Carsonite Witness Post
S68°E 14.8' 7" Oak
S88°W 7.7' Cedar post
S16°E 30.8' 8" J. Pine
N14°E 77.3' 10" J. Pine

STATE OF MICHIGAN
NORMAN C. CALDWELL
LAND SURVEYOR
12018
REGISTERED LAND SURVEYOR

gned by Norman C. Caldwell Date April 26, 1990

urveyor's Michigan License No. 12018

FORM APPROVED BY MICHIGAN STATE BOARD OF LAND SURVEYORS, JAN. 28, 1971
REVISED MAY 14, 1975
REVISED JAN., 1983