

LIBER 2 PAGE 341

LAND CORNER RECORDATION CERTIFICATE Filing Requirement of Act 74, Mich. P.A. 1970

STATE OF MICHIGAN
COUNTY OF CRAWFORD

For corners in

Crawford
(County)

Located In: Corner Code //

- | | | | | | |
|------------------------------------|---|-----|---|----|-----|
| 1. Public Land Survey | T | 27N | R | 1W | F-9 |
| | T | | R | | |
| | T | | R | | |
| | T | | R | | |
| 2. Property Controlling in Section | S | T | R | | |
| | S | T | R | | |
| 3. Miscellaneous Property in Sec. | S | T | R | | |
| | S | T | R | | |

FILED FOR RECORD THIS
6th DAY OF June, 1990 AT
9:30 am/pm, IN LIBER 2
PAGE 341.

Edgar S. Wisland
Register of Deeds

Register of Deeds Stamp & File Number

1. Lot No. Recorded Plat
2. Private Claims

	A	B	C	D	E	F	G	H	I	J	K	L	M
2	6	5	4	3	2	1							
3													
4	7	8	9	10	11	12							
5													
6	18	17	16	15	14	13							
7													
8	19	20	21	22	23	24							
9													
10	30	29	28	27	26	25							
11													
12	31	32	33	34	35	36							
13													

Norman C. Caldwell in a field survey on **March**, 1990

to hereby certify that under requirements of P.A. 74, Michigan P.A. of 1970, the corner points mentioned in lines 1 and 2 above were in conformance with regulations and rules therefore as required in the current manual of survey instructions of the United States Department of the Interior, Bureau of Land Management or by a decree of a Court of Law and/or that the corner points mentioned in lines 3, 4 and 5 above were in conformance with the rules of the Michigan Board of Land Surveyors or by a Decree of a Court of Law, established, re-established, monumented, re-monumented, recovered, found as expressed below:


NOTE: Not more than 4 corners, all in the same town and range, may be recorded on this certificate.

1. Description of original monument and accessories and/or subsequent restoration:

- (E-9) Post set by Pettibone, July 25, 1852.
Spruce Pine 9" S04°W .51 (33.66')
Spruce Pine 10" S61°E 1.25 (82.50')

1. Description of corner evidence found and/or method applied in restoring or reestablishing corner:

- (E-9) LaGuire fnd. a cor. 1934 and placed pipe-& conc. block.
K.J. Ostling, LS 10068, placed DNR pipe & cap, May 27, 1975.
S58°W 79.8' 20" R. Pine
S25°E 51.0' 8" Oak
rec. in L 2, pg 28

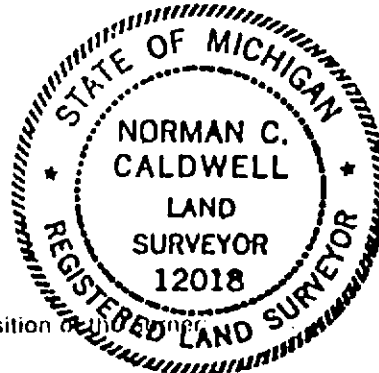

Description of monument for corner and accessories established to perpetuate locating the position of the corner:

- (E-9) Sec. cor., 20, 21, 28 & 29, T27N-R1W

Fnd 1" I.P. w/no cap, in CL N-S Rd, and upon exam. fnd. to be 66'+ N. of the proper position which is fnd. to be mon. with a 60d spike. Following a review w/Carl Johnson, DNR surveyor, the pipe was moved to proper position. Accepted as a careful & faithful reestablishment of the position of the original corner.
West 20' Carsonite Witness Post N65°W 81.5' 24" N. Pine (old BT facing other position)
S30°E 70.8' 12" N. Pine
N50°E 29.6' 10" Oak stump (old BT facing other position)
N25°W 46.2' P. Pole

igned by

Date

April 26, 1990

urveyor's Michigan License No. 12018