

LAND CORNER RECORDATION CERTIFICATE
Filing Requirement of Act 74, Mich. P.A. 1970

STATE OF MICHIGAN
COUNTY OF CRAWFORD

FILED FOR RECORD THIS
6th DAY OF June, 1990
9:30 am/pm, in LIBER 2
PAGE 342.
Robert Williams
Register of Deeds

of corners in
Crawford (County)
Public Land Survey Located In: Corner Code //
T 27N R 1W E-10
T R
T R
T R
Property Controlling S T R
in Section S T R
Miscellaneous S T R
Property in Sec. S T R
Lot No. Recorded Plat
Private Claims

Register of Deeds Stamp & File Number

Norman C. Caldwell, a field survey on March 19 90
do hereby certify that under requirements of P.A. 74, Michigan P.A. of 1970, the corner points mentioned in lines 1 and 2 above were in conformance with regulations and rules therefore as required in the current manual of survey instructions of the United States Department of the Interior, Bureau of Land Management or by a decree of a Court of Law and/or that the corner points mentioned in lines 3, 4 and 5 above were in conformance with the rules of the Michigan Board of Land Surveyors or by a Decree of a Court of Law; established, re-established, monumented, re-monumented, recovered, found as expressed below.

	A	B	C	D	E	F	G	H	I	J	K	L	M
2	6		5		4		3		2		1		
3													
4	7		8		9		10		11		12		
5													
6	18		17		16		15		14		13		
7													
8	19		20		21		22		23		24		
9													
10	30		29		28		27		26		25		
11													
12	31		32		33		34		35		36		
13													

NOTE: Not more than 4 corners, all in the same town and range, may be recorded on this certificate.

Description of original monument and accessories and/or subsequent restoration.


(E-10) Post set by Pettibone, July 25, 1852.
Spruce Pine 7" N79°W .31 (20.46')
Spruce Pine 8" N68°E .95 (62.70')

Description of corner evidence found and/or method applied in restoring or reestablishing corner:

(E-10) LaGuire fnd. decayed post & placed pipe & conc. mon. 1934.
K.J. Ostling, LS 10068 fnd. pipe & conc. block Nov. 22, 1974.
S56°E 55.85' 7" J. Pine
S31°W 51.7' 5" J. Pine
rec. in L 2, pg 41

Description of monument for corner and accessories established to perpetuate locating the position:

(E-10) 1/4 cor. 28&29, T27N-R1W
Fnd. 1 1/2" pipe in CL gravel road w/40d spike in center.
S75°E 30' Carsonite Witness Post
N24°W 54.8' 12" Oak
S76°E 42.6' 11" J. Pine
S56°E 56.6' 10" J. Pine (R)
S46°W 72.5' 6" J. Pine

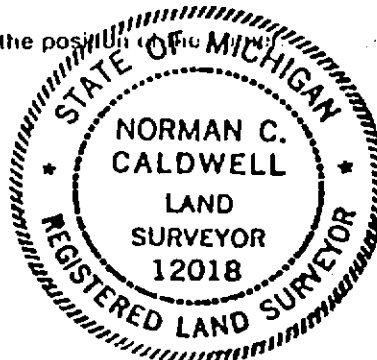

signed by *Norman C. Caldwell*
Surveyor's Michigan License No. 12018

Date April 26, 1990