

LAND CORNER RECORDATION CERTIFICATE
Filing Requirement of Act 74, Mich. P.A. 1970

STATE OF MICHIGAN
COUNTY OF CRAWFORD

For corners in

	Crawford <small>(County)</small>	Located in:	Corner Code //
1. Public Land Survey		T 27N R 1W	E-11
		T R	
		T R	
		T R	
2. Property Controlling in Section	S	T R	
	S	T R	
3. Miscellaneous Property in Sec.	S	T R	
	S	T R	

FILED FOR RECORD THIS
6th DAY OF June 1990 AT
9:30 am/pm, IN LIBER 2
PAGE 343
Robert Williams
Register of Deeds

Register of Deeds Stamp & File Number

- 1. Lot No. Recorded Plat
- 2. Private Claims

	A	B	C	D	E	F	G	H	I	J	K	L	M
2	6	5	4	3	2	1							
3													
4	7	8	9	10	11	12							
5													
6	18	17	16	15	14	13							
7													
8	19	20	21	22	23	24							
9													
10	30	29	28	27	26	25							
11													
12	31	32	33	34	35	36							
13													

Norman C. Caldwell in a field survey on March 19 90

to hereby certify that under requirements of P.A. 74, Michigan P.A. of 1970, the corner points mentioned in lines 1 and 2 above were in conformance with regulations and rules therefore as required in the current manual of survey instructions of the United States Department of the Interior, Bureau of Land Management or by a decree of a Court of Law and/or that the corner points mentioned in lines 3, 4 and 5 above were in conformance with the rules of the Michigan Board of Land Surveyors or by a Decree of a Court of Law; established, re-established, monumented, re-monumented, recovered, found as expressed below:

NOTE: Not more than 4 corners, all in the same town and range, may be recorded on this certificate.

1. Description of original monument and accessories and/or subsequent restoration:

- (E-11) Post set by Pettibone, July 25, 1852.
Y. Pine 12" S49°E .84 (55.44')
Spruce Pine 12" S17°W .77 (50.82')

2. Description of corner evidence found and/or method applied in restoring or reestablishing corner:


- (E-11) LaGuire placed pipe & conc. mon. from orig. BTs. 1934.
K.J. Ostling, LS 10068 fnd. pipe & conc. mon. May 27, 1975
S22°E 86.6' 9" R. Pine
S56°W 25.7' 8" Oak
rec. in L 2, pg 28

3. Description of monument for corner and accessories established to perpetuate locating the position of the corner:

- (E-11) Sec. cor. 28, 29, 32 & 33, T27N-R1W

Fnd. 1 1/2" pipe by LaGuire, 1934
And is accepted as a careful & faithful perpetuation of the position of the orig. cor.

- N40°W 30' Carsonite Witness Post N84°E 102.0' 9" Oak
- S56°W 26.2' 12" Oak (R)
- N34°W 54.6' 11" Oak
- S25°E 87.1' 12" R. Pine (R)

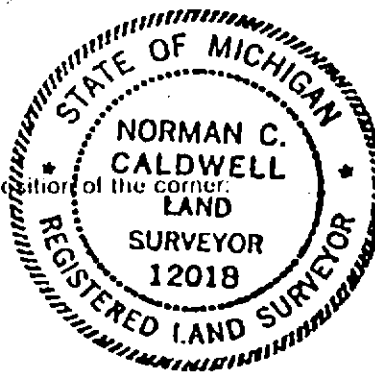

signed by *Norman C. Caldwell*
Surveyor's Michigan License No. 12018

Date April 26, 1990