

LAND CORNER RECORDATION CERTIFICATE
Filing Requirement of Act 74, Mich. P.A. 1970

For corners in
Crawford (County) Located In: Corner Code //

Public Land Survey T 27NR 1W E-13
T R
T R
T R

Property Controlling S T R
in Section S T R
Miscellaneous S T R
Property in Sec. S T R

Lot No. Recorded Plat
Private Claims

FILED FOR RECORD 1990
6th DAY OF June 15 1990
9:32 am, IN LIBER 2
PAGE 345
Norman C. Caldwell
REGISTERED LAND SURVEYOR

Register of Deeds Stamp & File Number

Norman C. Caldwell a field survey on March 19 90
do hereby certify that under requirements of P.A. 74, Michigan P.A. of 1970, the corner points mentioned in lines 1 and 2 above were in conformance with regulations and rules therefore as required in the current manual of survey instructions of the United States Department of the Interior, Bureau of Land Management or by a decree of a Court of Law and/or that the corner points mentioned in lines 3, 4 and 5 above were in conformance with the rules of the Michigan Board of Land Surveyors or by a Decree of a Court of Law; established, re-established, monumented, re-monumented, recovered, found as expressed below:

NOTE: Not more than 4 corners, all in the same town and range, may be recorded on this certificate.

Description of original monument and accessories and/or subsequent restoration:

(E-13) Aspen 10" in diameter for cor. to Sec. 32&33.
Pettibone intersects South boundary at post, July 25, 1852.
Poplar 9" N60°W .06 (3.96')
Birch 18" N55°E .21 (13.86')


Description of corner evidence found and/or method applied in restoring or reestablishing corner:

(E-13) LaGuire set pipe & conc. mon. 1934.
Mon. fnd. by Gerschbacher, LS 18990, April 3, 1989.
N53°E 46.64' 15" Maple
N70°W 50.62' 12" Maple
S46°W 24.10' 8" Maple
S24°E 27.76' 8" Balsm
rec. in L 2, pg 319

Description of monument for corner and accessories established to perpetuate locating the position of the

(E-13) Standard cor. 32&33, T27N-R1W
Fnd. 1 1/2" I.P. in conc. by LaGuire. Accepted as a careful & faithful reestablishment of the position of the original corner.
North 1' Carsonite Witness Post
N53°E 46.62' 15" Maple (R)
N70°W 50.62' 12" Maple (R)
S46°W 24.10' 8" Maple (R)
S24°E 27.76' 8" Balsm (R)

	A	B	C	D	E	F	G	H	I	J	K	L	M
2	6	5	4	3	2	1							
3													
4	7	8	9	10	11	12							
5													
6	18	17	16	15	14	13							
7													
8	19	20	21	22	23	24							
9													
10	30	29	28	27	26	25							
11													
12	31	32	33	34	35	36							
13													

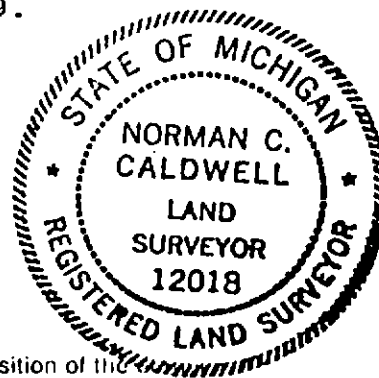

signed by *Norman C. Caldwell*
Surveyor's Michigan License No. 12018

Date April 26, 1990