

LIBER 2 PAGE 346

LAND CORNER RECORDATION CERTIFICATE Filing Requirement of Act 74, Mich. P.A. 1970

STATE OF MICHIGAN
COUNTY OF CRAWFORD

or corners in

Crawford <small>(County)</small>	Located In:	Corner Code //	
Public Land Survey	T 27N R 1W	F-9 F-11	
	T R		
	T R		
	T R		
Property Controlling in Section	S T R		
Miscellaneous	S T R		
Property in Sec.	S T R		

FILED FOR RECORD THIS
6th DAY OF *June*, 19*90* AT
9:30 AM/P.M. IN LIBER *2*
PAGE *346*.
Robert Wilam
Register of Deeds

Register of Deeds Stamp & File Number

Lot No. Recorded Plat
Private Claims


Norman C. Caldwell field survey on **March**, 19 **90**
I hereby certify that under requirements of P.A. 74, Michigan P.A. of 1970, the corner points mentioned in lines 1 and 2 above were in conformance with regulations and rules therefore as required in the current manual of survey instructions of the United States Department of the Interior, Bureau of Land Management or by a decree of a Court of Law and/or that the corner points mentioned in lines 3, 4 and 5 above were in conformance with the rules of the Michigan Board of Land Surveyors or by a Decree of a Court of Law, established, re-established, monumented, re-monumented, recovered, found as expressed below.

NOTE: Not more than 4 corners, all in the same town and range, may be recorded on this certificate.

	A	B	C	D	E	F	G	H	I	J	K	L	M
2	6	5	4	3	2	1							
3													
4	7	8	9	10	11	12							
5													
6	18	17	16	15	14	13							
7													
8	19	20	21	22	23	24							
9													
10	30	29	28	27	26	25							
11													
12	31	32	33	34	35	36							
13													

Description of original monument and accessories and/or subsequent restoration:

- (F-9) Post set by Pettibone, July 25, 1852.
Y. Pine 7" N44°W 1.00 (66.00')
Spruce Pine 4" S06°W 1.22 (80.52')
- (F-11) Post set by Pettibone, July 25, 1852.
Spruce Pine 12" N10°E .35 (23.10')
Y. Pine 12" S66°E .49 (32.34')

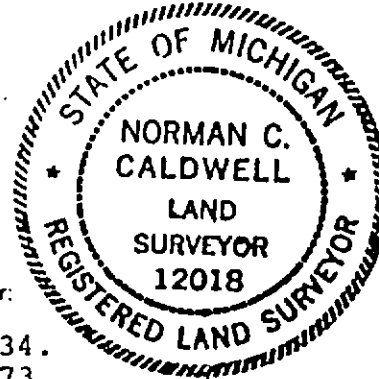

Description of corner evidence found and/or method applied in restoring or reestablishing corner:

- (F-9) LaGuire placed pipe & conc. mon. by proportion, 1934.
K.J. Ostling, LS 10068, recovered mon. Dec. 28, 1973.
N47°E 12.0' 6" J. Pine
N27°W 23.5' 8" J. Pine
rec. in L 1, pg 11 & L 2, pg 101
J. Korr, LS 24600, has apparently ref. this cor. but has not placed document of record.
- (F-11) LaGuire set pipe & conc. mon. 1934. from both orig. BTs.
K.J. Ostling, LS 10068, fnd. mon. Dec. 28, 1973.
N75°W 3.4' 8" Twin Thorn Apple
S17°E 79.0' 7" Oak
rec. in L 1, pg 11 & L 2, pg 101

Description of monument for corner and accessories established to perpetuate locating the position of the corner:

- | | |
|---|---|
| <p>(F-9) <u>1/4 cor. 21&28, T27N-R1W</u>
Fnd. DNR pipe & cap. Accepted as a careful & faithful reestablishment of the position of the orig. corner.
North 1' Carsonite Witness Post
N88°W 11.9' 4" J. Pine
S12°E 17.8' 4" J. Pine
S30°E 38.1' 3" J. Pine
N79°E 20.4' 4" J. Pine</p> | <p>(F-11) <u>1/4 cor. 28&33, T27N-R1W</u>
Fnd DNR pipe & cap. And is accepted as a careful & faithful perpet. of the pos. of the orig. cor.
North 1' Carson. Wit Post
N83°W 58.0' 12" Maple
N08°E 94.3' 9" Oak
N70°E 47.0' 12" Twin Oak
S56°E 34.9' 12" Oak</p> |
|---|---|

Signed by *Norman C. Caldwell*
Surveyor's Michigan License No. 12018

Date April 26, 1990