

LAND CORNER RECORDATION CERTIFICATE
Filing Requirement of Act 74, Mich. P.A. 1970

STATE OF MICHIGAN
COUNTY OF CRAWFORD

or corners in

Crawford Located In: Corner Code //

Public Land Survey T27N R1W G-8 G-9

Property Controlling S T H

in Section S 1 R

Miscellaneous S T R

Property in Sec. S T R

FILED FOR RECORD THIS
6th DAY OF June, 1990 AT
9:30 a.m. in LIBER 2
PAGE 348.
E. J. ...
Register of Deeds

Register of Deeds Stamp & File Number

Lot No. Recorded Plat

Private Claims


	A	B	C	D	E	F	G	H	I	J	K	L	M
2	6	5	4	3	2	1							
3													
4	7	8	9	10	11	12							
5													
6	18	17	16	15	14	13							
7													
8	19	20	21	22	23	24							
9													
10	30	29	28	27	26	25							
11													
12	31	32	33	34	35	36							
13													

Norman C. Caldwell a field survey on March 19 90
I hereby certify that under requirements of P.A. 74, Michigan P.A. of 1970, the corner points mentioned in lines 1 and 2 above were in conformance with regulations and rules thereto as required in the present manual of survey instructions of the United States Department of the Interior, Bureau of Land Management or by a decree of a Court of Law and/or that the corner points mentioned in lines 3, 4 and 5 above were in conformance with the rules of the Michigan Board of Land Surveyors or by a Decree of a Court of Law, established, re-established, monumented, re-monumented, recovered, found as expressed below:

NOTE: Not more than 4 corners, all in the same town and range, may be recorded on this certificate.

Description of original monument and accessories and/or subsequent restoration:

- (G-8) Post set by Pettibone, July 23, 1852.
Spruce Pine 3" S45°E .20 (13.20')
Spruce Pine 3" S30°W .45 (29.70')
- (G-9) Post set by Pettibone, July 23, 1852.
Spruce Pine 8" S58°W .26 (17.16')
Spruce Pine 8" S17°E .37 (24.42')

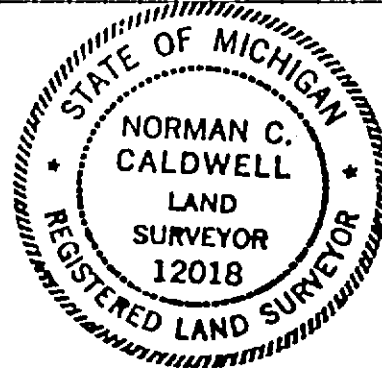

Description of corner evidence found and/or method applied in restoring or reestablishing corner:

- (G-8) A survey by Paul Heinsie & Son dated 1921 does not indicate mon. used. LaGuire notes do not indicate finding or placing a mon. 1934. R.T. Ostling survey of Oct. 1953 does not indicate finding or placing a mon.
N. Parker, LS 16939, fnd 1" bar & rec. in L 2, pg 102
C. Johnson, LS 30083, placed DNR pipe & cap 1-11-88
- (G-9) LaGuire fnd. a cor. of good standing & placed pipe & conc. mon.
N52°W 54.5' 20" Y. Pine
N78°E 45.5' 16" J. Pine
K.J. Ostling, LS 10068, fnd. mon on May 27, 1975, rec. in L 2, pg 28
N59°W 10.3' 24" R. Pine
S38°W 52.4' P. Pole

Description of monument for corner and accessories established to perpetuate locating the position of the corner:

- (G-8) 1/4 cor. 21&22, T27N-R1W
Fnd DNR pipe & cap CL trail. Accepted as the best avail. evid. of the posit. of the orig. cor.
West 5' Carsonite Witness Post
N05°W 78.1' P. Pole
S72°E 26.5' 5" J. Pine
S58°W 40.7' 5" R. Pine
N46°W 37.6' 6" R. Pine
- (G-9) Sec. cor. 21,22,27&28, T27N-R1W
Fnd. 1 1/2" Pipe by LaGuire in CL trail. Accepted as the best avail. evid. of the posit. of the orig. cor.
East 10' Carsonite Wit. Post
S79°E 17.9' 5" J. Pine
N62°W 10.6' 24" R. Pine (R)
S36°W 52.6' P. Pole (R)
S18°E 72.5' 11" J. Pine
West 8'+ Cedar post

signed by

Date

April 26, 1990

Surveyor's Michigan License No. 12018