

LAND CORNER RECORDATION CERTIFICATE
Filing Requirement of Act 74, Mich. P.A. 1970

STATE OF MICHIGAN
COUNTY OF CRAWFORD

FILED FOR RECORD THIS
6th DAY OF June 1990
9:30 am/pm, in LIBER 2
PAGE 349.
Robert Whitcomb
Register of Deeds

For corners in
Crawford (County)
Located In: Corner Code //

1. Public Land Survey	T	27NR 1W	G-10
	T	R	
	T	R	
	T	R	
2. Property Controlling in Section	S	1	R
	S	1	R
3. Miscellaneous Property in Sec.	S	T	R
	S	T	R

Register of Deeds Stamp & File Number

1. Lot No. Recorded Plat
2. Private Claims

	A	B	C	D	E	F	G	H	I	J	K	L	M
2	6	5	4	3	2	1							
3													
4	7	8	9	10	11	12							
5													
6	18	17	16	15	14	13							
7													
8	19	20	21	22	23	24							
9													
10	30	29	28	27	26	25							
11													
12	31	32	33	34	35	36							
13													

Norman C. Caldwell in a field survey on March 19 90

to hereby certify that under requirements of P.A. 74, Michigan P.A. of 1970, the corner points mentioned in lines 1 and 2 above were in conformance with regulations and rules therefore as required in the current manual of survey instructions of the United States Department of the Interior, Bureau of Land Management or by a decree of a Court of Law and/or that the corner points mentioned in lines 3, 4 and 5 above were in conformance with the rules of the Michigan Board of Land Surveyors or by a Decree of a Court of Law; established, re-established, monumented, re-monumented, recovered, found as expressed below:


NOTE: Not more than 4 corners, all in the same town and range, may be recorded on this certificate.

Description of original monument and accessories and/or subsequent restoration:

(G-10) Post set by Pettibone, July 23, 1852.
Spruce Pine 12" N79°W .21 (13.86')
Spruce Pine 12" N59°E .14 (9.24')

Description of corner evidence found and/or method applied in restoring or reestablishing corner:

(G-10) LaGuire, 1934, placed pipe & conc. block by proportion.
K.J. Ostling, LS 10068, fnd. mon. November 22, 1974.
N82°W 62.0' 7" J. Pine
S10°E 52.2' 8" J. Pine
recorded in L. 2, pg. 41

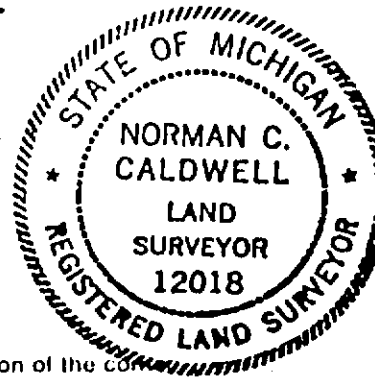

Description of monument for corner and accessories established to perpetuate locating the position of the corner:

(G-10) 1/4 cor. 27&28, T27N-R1W
Fnd. 1 1/2" pipe in block of conc. in CL trail by LaGuire.
Accepted as a careful & faithful reestablishment of the position of the original corner.
East 10' Carsonite Witness Post N82°W 62' 7" J. Pine
N16°W 58.6' 8" R. Pine S10°E 52.2' 8" J. Pine
N14°E 25.9' 8" R. Pine
N64°E 36.2' 8" J. Pine
S26°W 22.2' 9" J. Pine

Norman C. Caldwell

signed by
Surveyor's Michigan License No. 12018

Date April 26, 1990