

LAND CORNER RECORDATION CERTIFICATE
Filing Requirement of Act 74, Mich. P.A. 1970

STATE OF MICHIGAN
COUNTY OF CRAWFORD

FILED FOR RECORD THIS
6th DAY OF June 1990
9:30 AM BY LIBER 2
PAGE 350
[Signature]
REGISTER OF DEEDS

or corners in
Crawford County Located In: Corner Code //
Public Land Survey T 27N R 1W G-11
T R
T R
T R
Property Controlling S T R
in Section S T R
Miscellaneous S T R
Property in Sec. S T R

Register of Deeds Stamp & File Number

Lot No. Recorded Plat
Private Claims

	A	B	C	D	E	F	G	H	I	J	K	L	M
2	6	5	4	3	2	1							
3													
4	7	8	9	10	11	12							
5													
6	18	17	16	15	14	13							
7													
8	19	20	21	22	23	24							
9													
10	30	29	28	27	26	25							
11													
12	31	32	33	34	35	36							
13													

Norman C. Caldwell field survey on March 19 90
I hereby certify that under requirements of P.A. 74, Michigan P.A. of 1970, the corner points mentioned in lines 1 and 2 above were in conformance with regulations and rules therefore as required in the current manual of survey instructions of the United States Department of the Interior, Bureau of Land Management or by a decree of a Court of Law and/or that the corner points mentioned in lines 3, 4 and 5 above were in conformance with the rules of the Michigan Board of Land Surveyors or by a Decree of a Court of Law, established, re-established, monumented, re-monumented, recovered, found as expressed below:

OTE: Not more than 4 corners, all in the same town and range, may be recorded on this certificate.

Description of original monument and accessories and/or subsequent restoration:


(G-11) Post set by Pettibone, July 23, 1852.
Y. Pine 20" S70°E 1.29 (85.14')
Spruce Pine 13" S10°E .76 (50.16')

Description of corner evidence found and/or method applied in restoring or reestablishing corner:

(G-11) LaGuire, 1934, placed pipe & conc. block at original post, verified with both original BTs.
K.J. Ostling, LS 10068, replaced pipe & block with DNR pipe & cap mon., Dec. 28, 1973.
S78°E 71.5' 13" R. Pine
N45°E 29.2' 13" Oak
rec. in L 1, pg 11 & L 2, pg 101

Description of monument for corner and accessories established to perpetuate locating the position of the corner:

(G-11) Sec. cor. 27, 28, 33 & 34, T27N-R1W
Fnd. DNR pipe & cap. And is accepted as a careful & faithful perpetuation of the position of the original corner.
North 1' Carsonite Witness Post S70°E 85.1' 20" Y. Pine Orig. BT
N44°E 29.7' 14" Bl. Oak (R)
S79°E 71.9' 16" R. Pine (R)
S03°W 56.8' 8" J. Pine
N42°W 32.3' 10" Oak

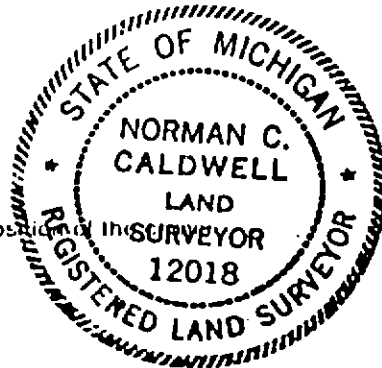

signed by [Signature]
Surveyor's Michigan License No. 12018

Date April 26, 1990