

LIBER

2 PAGE 351

LAND CORNER RECORDATION CERTIFICATE  
Filing Requirement of Act 74, Mich. P.A. 1970

or corners in

Crawford  
(County)

Located In:

Corner Code //

Public Land Survey

T27N R1W

G-12

T R

T R

T R

Property Controlling  
in Section

S T R

S T R

Miscellaneous

S T R

Property in Sec.

S T R

Lot No. Recorded Plat

Private Claims

2<sup>nd</sup> of June, 1990  
9:30  
351  
Register of Deeds

Register of Deeds Stamp & File Number

Norman C. Caldwell field survey on March 19 90

I hereby certify that under requirements of P.A. 74, Michigan P.A. of 1970, the corner points mentioned in lines 1 and 2 above were in conformance with regulations and rules therefore as required in the current manual of survey instructions of the United States Department of the Interior, Bureau of Land Management or by a decree of a Court of Law and/or that the corner points mentioned in lines 3, 4 and 5 above were in conformance with the rules of the Michigan Board of Land Surveyors or by a Decree of a Court of Law, established, re-established, monumented, re-monumented, recovered, found as expressed below:

NOTE: Not more than 4 corners, all in the same town and range, may be recorded on this certificate.


Description of original monument and accessories and/or subsequent restoration:

- (G-12) Post set by Pettibone, July 23, 1852.  
Tamarack 12" S22°W .11 (7.26')
- Tamarack 12" S55°E .22 (14.52')

Description of corner evidence found and/or method applied in restoring or reestablishing corner:

- (G-12) LaGuire, 1934, fnd. original post & BTs. Placed a pipe & conc. block.  
N52°W 5.3' 6" Spruce

	A	B	C	D	E	F	G	H	I	J	K	L	M
2	6	5	4	3	2	1							
3													
4	7	8	9	10	11	12							
5													
6	18	17	16	15	14	13							
7													
8	19	20	21	22	23	24							
9													
10	30	29	28	27	26	25							
11													
12	31	32	33	34	35	36							
13													

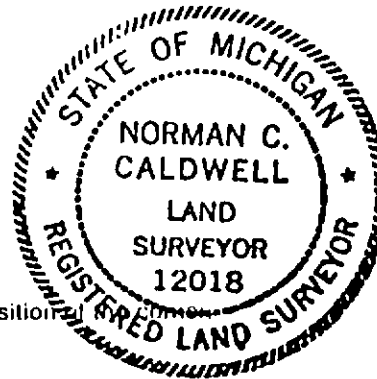

Description of monument for corner and accessories established to perpetuate locating the position:

- (G-12) 1/4 cor. 33&34, T27N-R1W

Fnd. 1 1/2" pipe & conc. block by Schaaf, (LaGuire) 10' S of E-W foot-path 150'+ E of Tamarack swamp edge, 100'+ W of the toe of slope 300'+ W of Cabin. And is accepted as a careful & faithful perpetuation of the position of the original corner.

- South 1' Carsonite Witness Post S10°W 14.4' 4" Tamarack
- N35°W 26.1' 6" Tamarack East 1.5' steel fc. post
- N50°E 29.8' 5" Tamarack S22°W 7.26' 12" Tamarack orig. BT (fnd. stump)
- S75°E 29.0' 7" Tamarack S55°E 14.52' 12" Tamarack orig. BT (fnd. stump)

Surveyed by [Signature] Date April 26, 1990  
Surveyor's Michigan License No. 12018