

LAND CORNER RECORDATION CERTIFICATE
Filing Requirement of Act 74, Mich. P.A. 1970

STATE OF MICHIGAN
COUNTY OF CRAWFORD

FILED FOR RECORD THIS
6th DAY OF June, 1990 AT
9:30 am, in LIBER 2
PAGE 352.
Norman C. Caldwell
Register of Deeds

or corners in	Crawford (County)	Located In	Corner Code //
Public Land Survey		T 27NR 1W	G-13
		T R	
		T R	
		T R	
Property Controlling in Section	S	T R	
Miscellaneous	S	T R	
Property in Sec.	S	T R	

Register of Deeds Stamp & File Number

Lot No. Recorded Plat
Private Claims

	A	B	C	D	E	F	G	H	I	J	K	L	M
2	6	5	4	3	2	1							
3													
4	7	8	9	10	11	12							
5													
6	18	17	16	15	14	13							
7													
8	19	20	21	22	23	24							
9													
10	30	29	28	27	26	25							
11													
12	31	32	33	34	35	36							
13													

Norman C. Caldwell field survey on March 19 90
I hereby certify that under requirements of P.A. 74, Michigan P.A. of 1970, the corner points mentioned in lines 1 and 2 above were in conformance with regulations and rules thereto as required in the present manual of survey instructions of the United States Department of the Interior, Bureau of Land Management or by a decree of a Court of Law and/or that the corner points mentioned in lines 3, 4 and 5 above were in conformance with the rules of the Michigan Board of Land Surveyors or by a Decree of a Court of Law; established, re-established, monumented, re-monumented, recovered, found as expressed below:


NOTE: Not more than 4 corners, all in the same town and range, may be recorded on this certificate.

Description of original monument and accessories and/or subsequent restoration:

- (G-13) Original post set by Mullett in 1839.
Pine 8" N63°E .24 (15.84')
Pine 8" N01°W .25 (16.50')
Replaced by Pettibone, July 23, 1852.
Spruce Pine 12" N76°W .15 (9.90')
Spruce Pine 9" N60°E .30 (19.80')

Description of corner evidence found and/or method applied in restoring or reestablishing corner:

- (G-13) LaGuire, 1934, fnd. original post & placed pipe & conc. block. He also fnd. a second post SE which could not be validated (Fargo?)

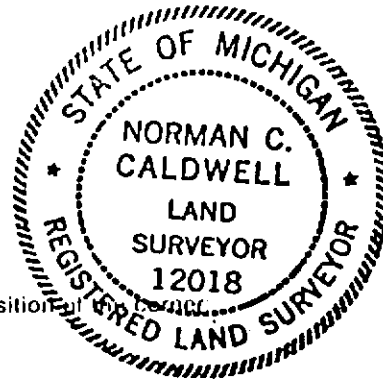

Description of monument for corner and accessories established to perpetuate locating the position:

- (G-13) Standard Cor. 33&J4, T27N-R1W

Fnd. DNR pipe w/cap @ edge of lake, no evidence of Fargo position. And is accepted as a careful & faithful perpetuation of the position of the original corner.
North 1' Carsonite Witness Post N35°W 15.6' 12" N. Pine stump
N10°W 72.8' 12" J. Pine (old BT)
N05°W 79.1' 7" Tam. (dead) (old BT)
N10°E 96.6' 12" J. Pine
N70°E 156.7' 5" J. Pine

signed by

Date April 26, 1990

Surveyor's Michigan License No. 12018